


T. 26S. R. 4 W. W.M.

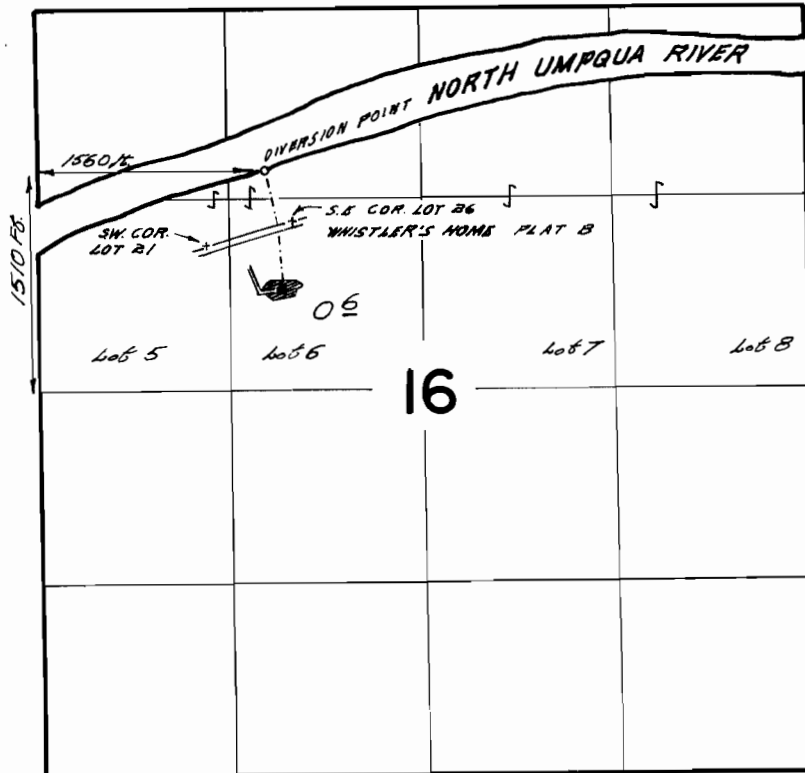

FINAL PROOF SURVEY
UNDER

TRANSFER N-29
Application No. Permit No.
IN NAME OF

NYE & ALLENBY

Surveyed June 28 1968, by *W. d. Ruppert*