


RECEIVED
103 7 19 1

STATE ENGINEER
SALEM, OREGON

T.24S.R.7W.W.M.

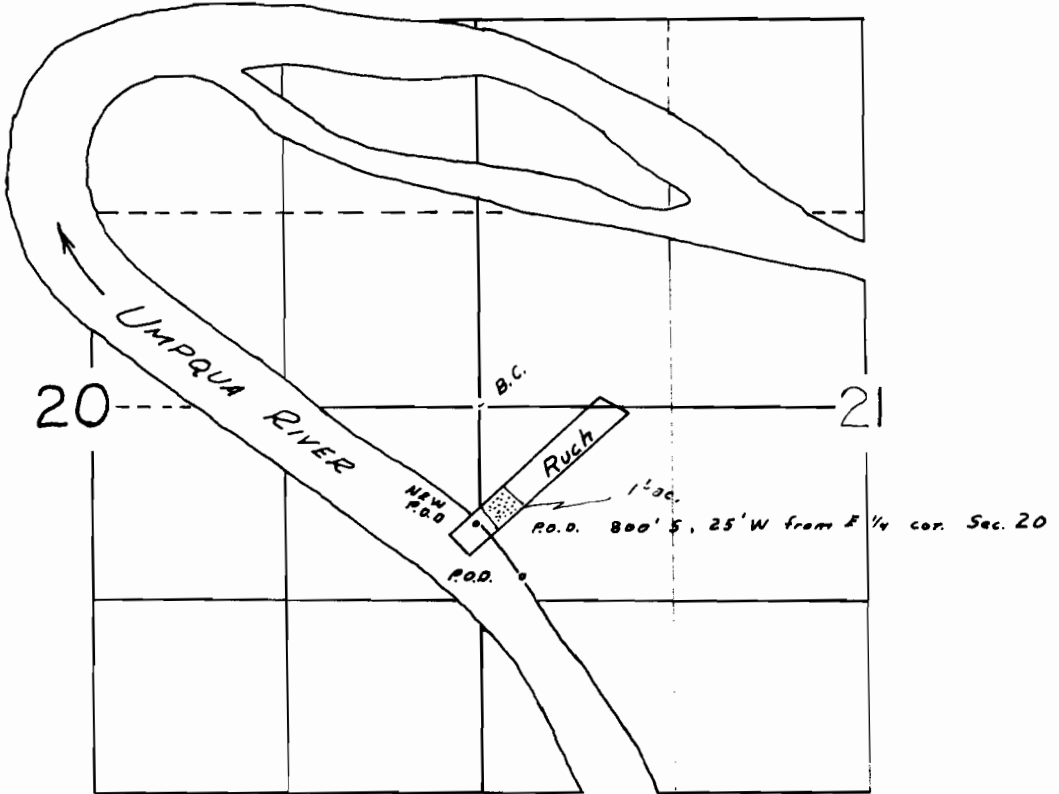

Scale: 1" = 1 Mile