


# T.8 S.R.2W.W.M.

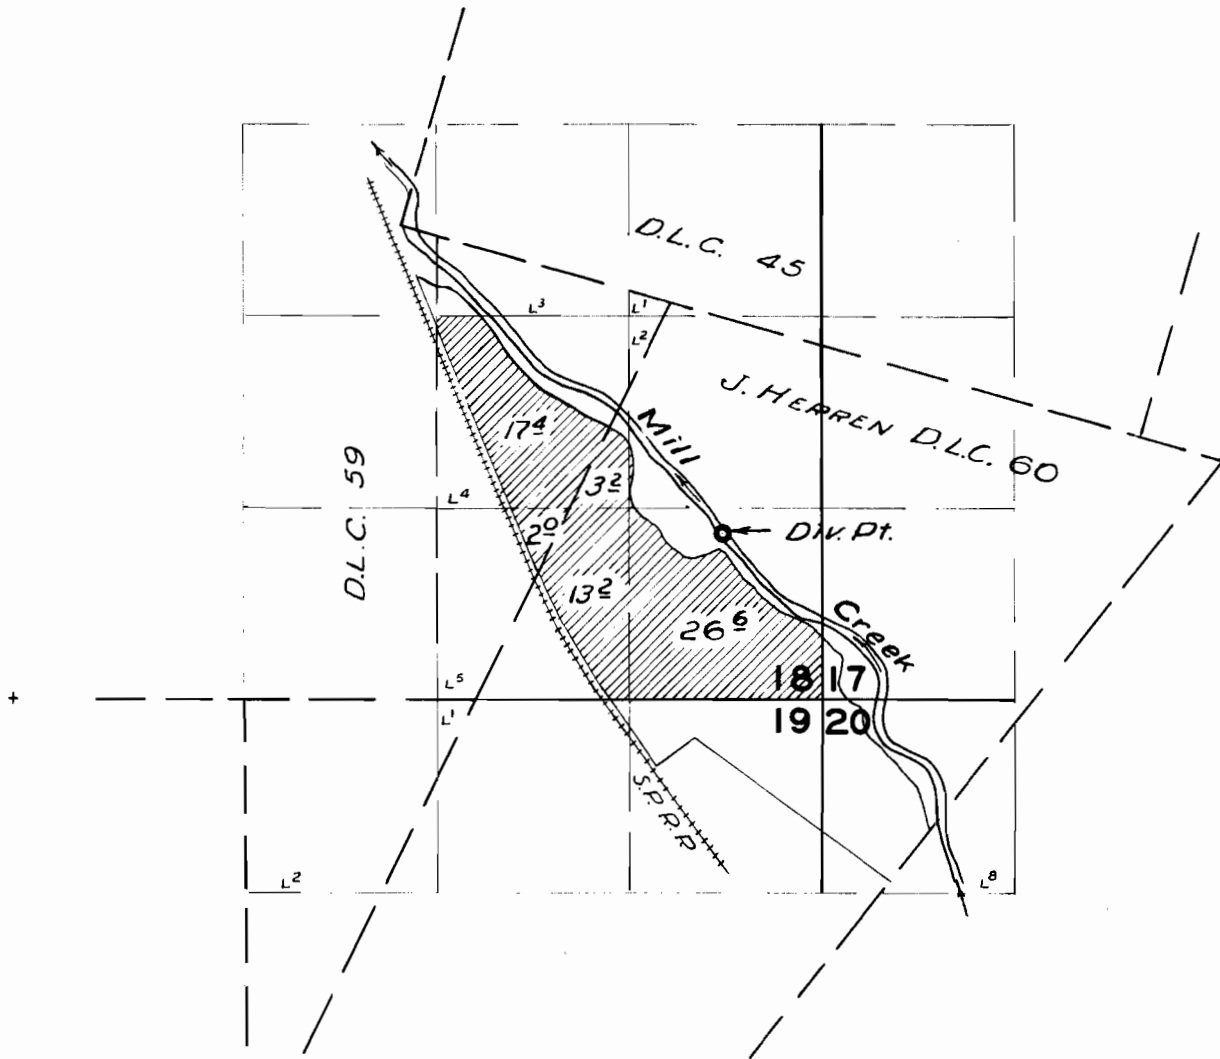

## FINAL PROOF SURVEY UNDER

TRANSFER NO. O-22

Application No. \_\_\_\_\_ Permit No. \_\_\_\_\_

IN NAME OF

OREGON STATE BOARD OF CONTROL

Surveyed 10 June 1959, by *m. Bish*