


Township 26 S. Range 4 W. W.M.

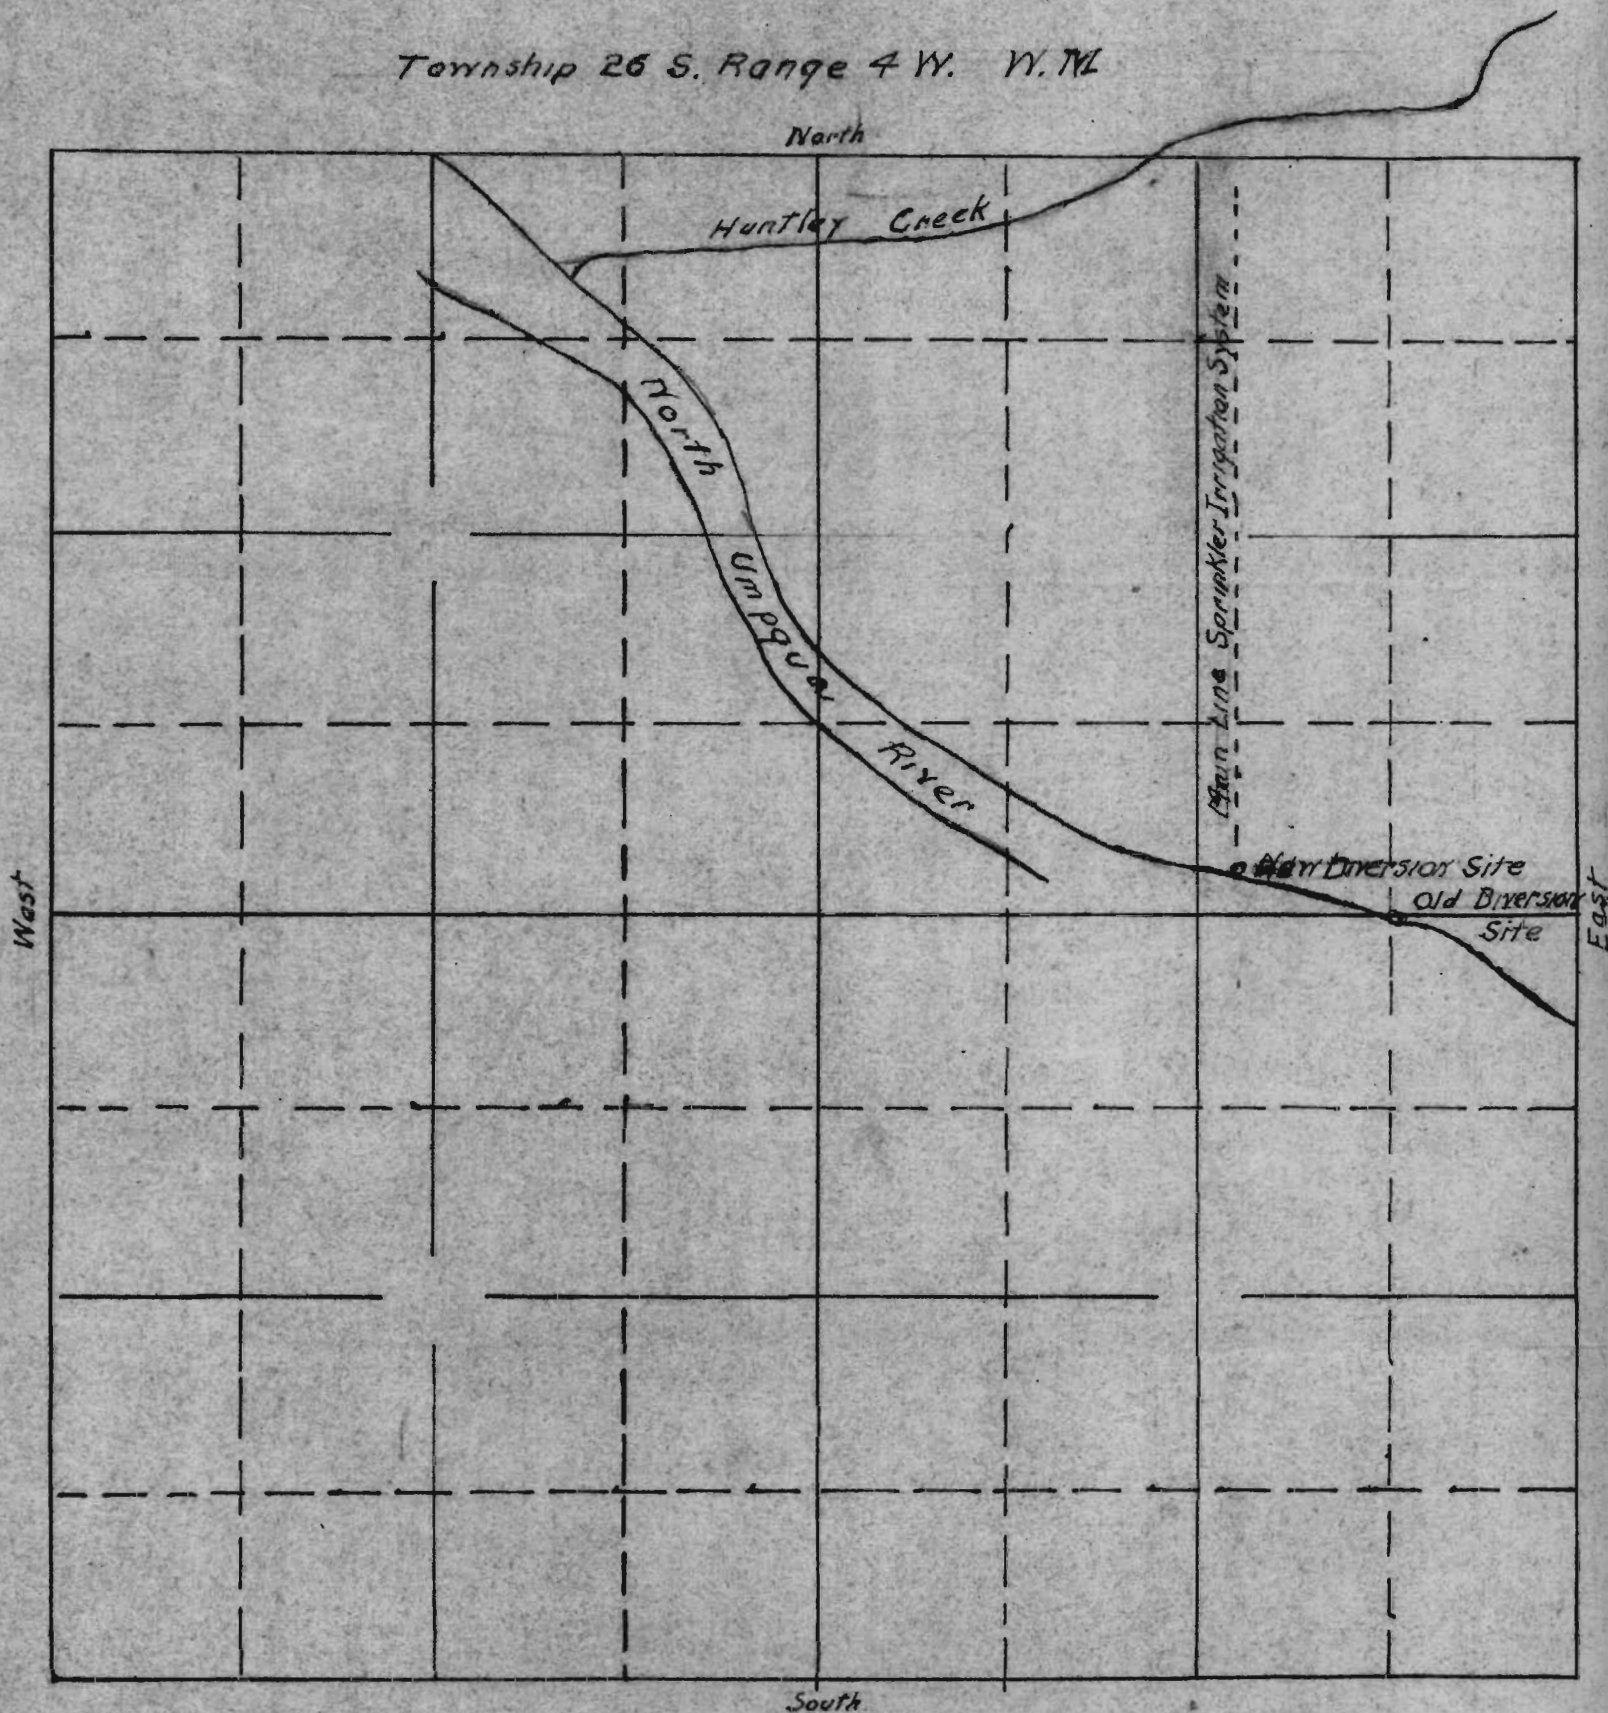

RECEIVED
AUG 22 1956
STATE ENGINEER
SALEM, OREGON

Permit No 12340