


T.6S.R.41E.W.M.

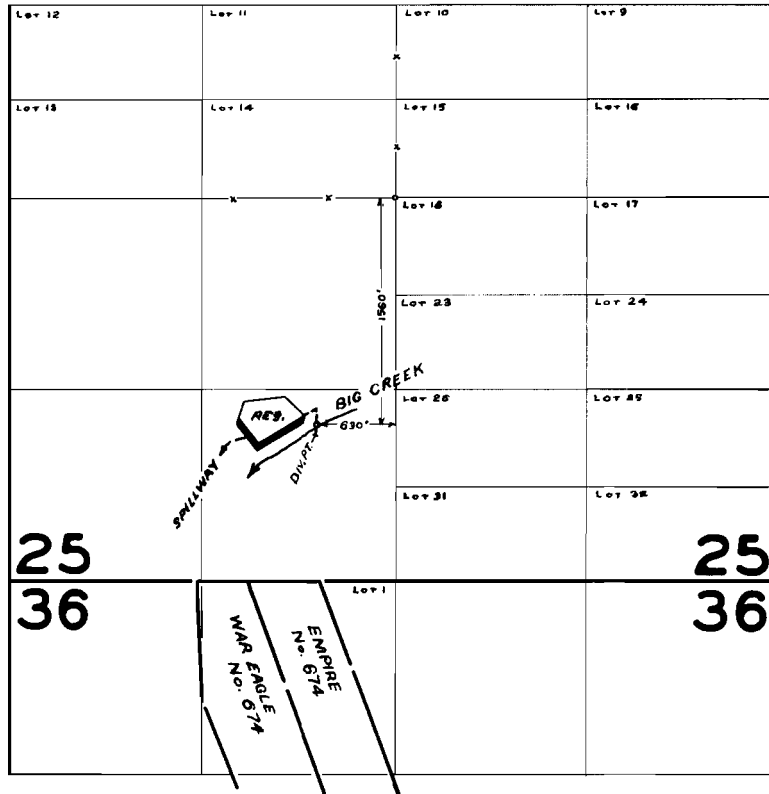

FINAL PROOF SURVEY UNDER

TRANSFER No. O-37

Application No. _____ Permit No. _____
IN NAME OF

OREGON STATE GAME COMMISSION

Surveyed *Nov. 2* 1965, by *C. GARDNER*