


T.40S., R.8W., W.M.

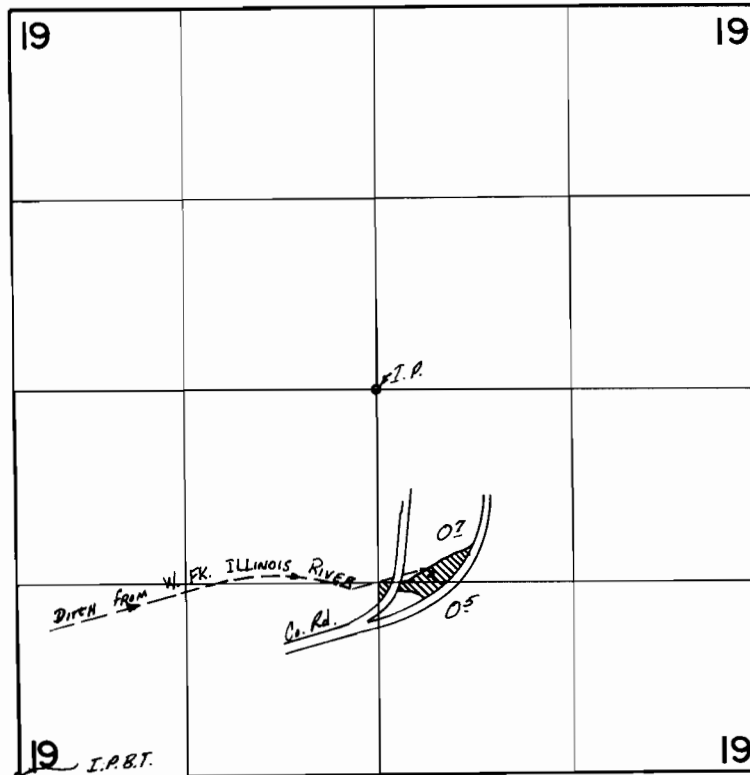

*Goold*

**FINAL PROOF SURVEY**  
UNDER

TRANS. No. 0-57

Application No. .... Permit No. ....  
IN NAME OF

..... *HARRY & VIRGINIA SONNIER* .....

Surveyed *31 Oct.* 19*72*, by *L.E. GOULD*