


T. 6 S. R. 3 W. W. M.

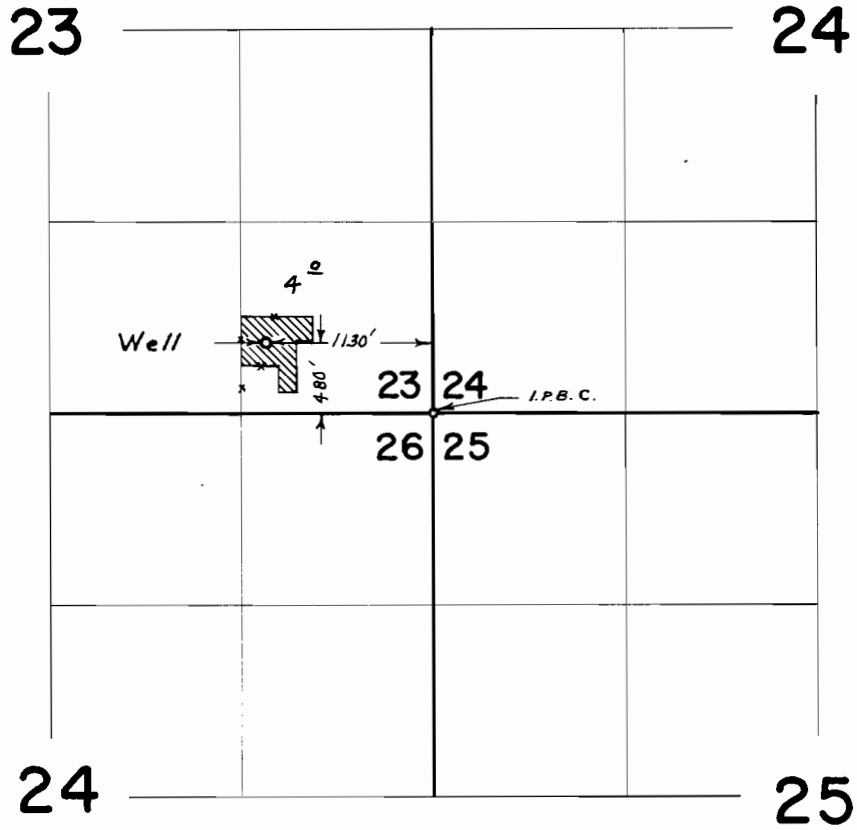

FINAL PROOF SURVEY
UNDER

Application No. _____ TRANSFER 0-58
Permit No. _____
IN NAME OF
JOE W. OPPEK

Surveyed Nov. 18, 1969, by L. E. Gould.