


T. 39 S., R. 7 W., W. M.

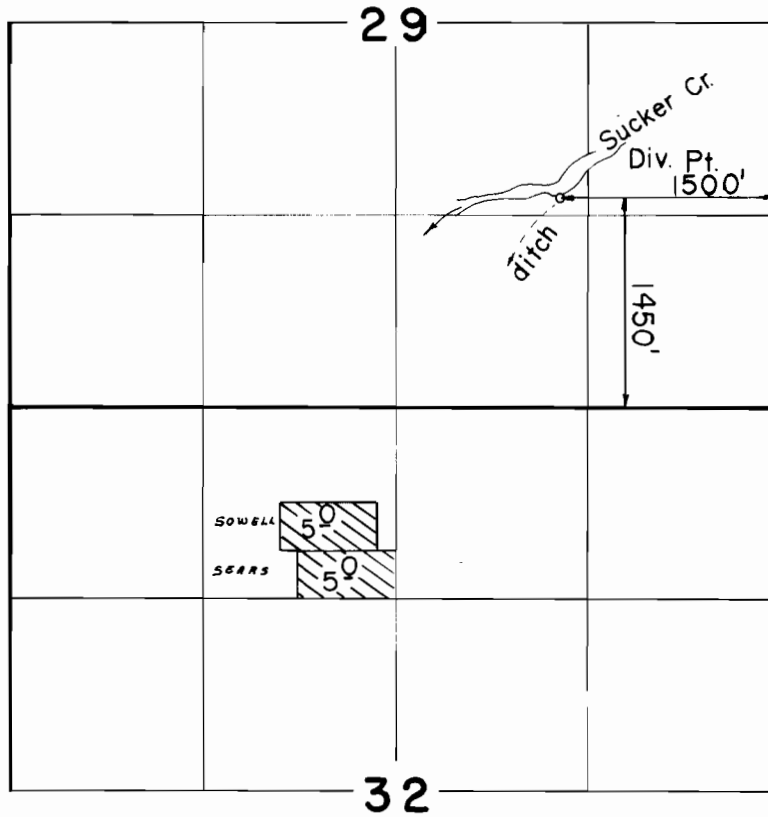

Scale: 1" = 1320'

### FINAL PROOF SURVEY

UNDER

TRANSFER NO. 0-59

Application No. .... Permit No. ....

IN NAME OF

..ALTON...&...EDITH...SOWELL...

Surveyed MAY 14, 1986, by B. S. JAMES.