


T. 3 S. R. 5 W. W. M.

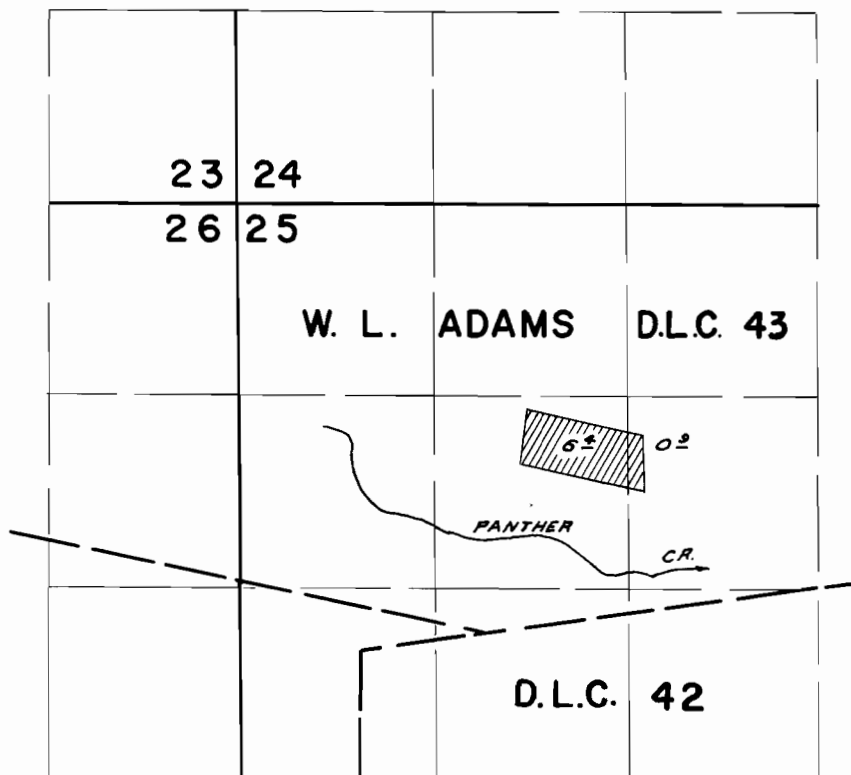

FINAL PROOF SURVEY
UNDER

TRANSFER P-68

Application No. Permit No.

IN NAME OF

DARREL L. PARNELL

Surveyed AUG 17, 1965, by L. COLEBANK