


T.1S.R.25E.W.M.

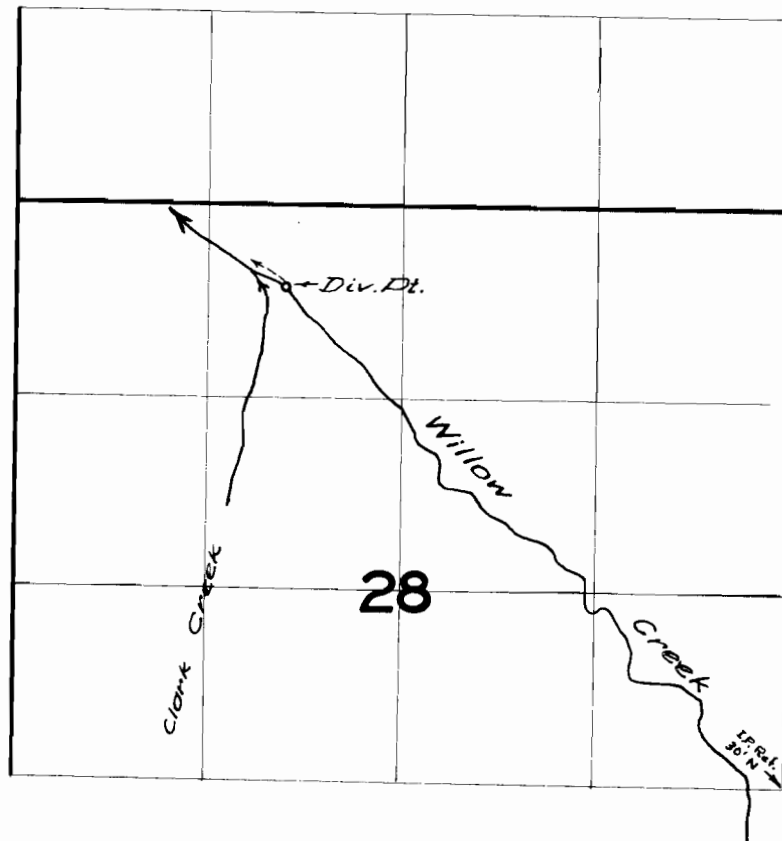

FINAL PROOF SURVEY
UNDER

Transfer No. *P-45*

Application No. _____ Permit No. _____

IN NAME OF

..... *L. A. PALMER*

Surveyed *20 Oct.* 1958, by *M. Bish*