


T-1641

T. 4S. R. 11 & 12E W.M.

RECEIVED
JUL - 2 1962
STATE ENGINEER
SALEM, OREGON

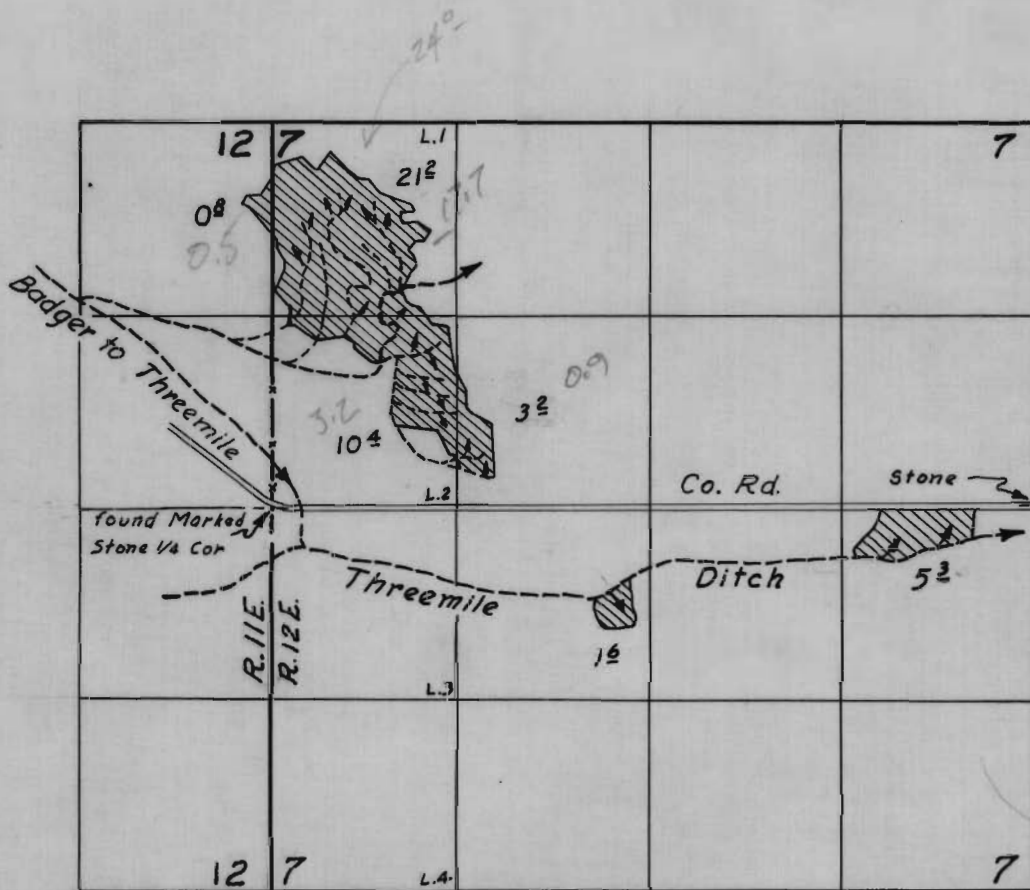

FINAL PROOF SURVEY
UNDER

Application Transfer No. P-59
IN NAME OF

William & Arthur Peetz

Surveyed April 12 1962, by L. W. Debousek