


T2N R15E W1M  
T. 2 N. R. 15 E. W. M.

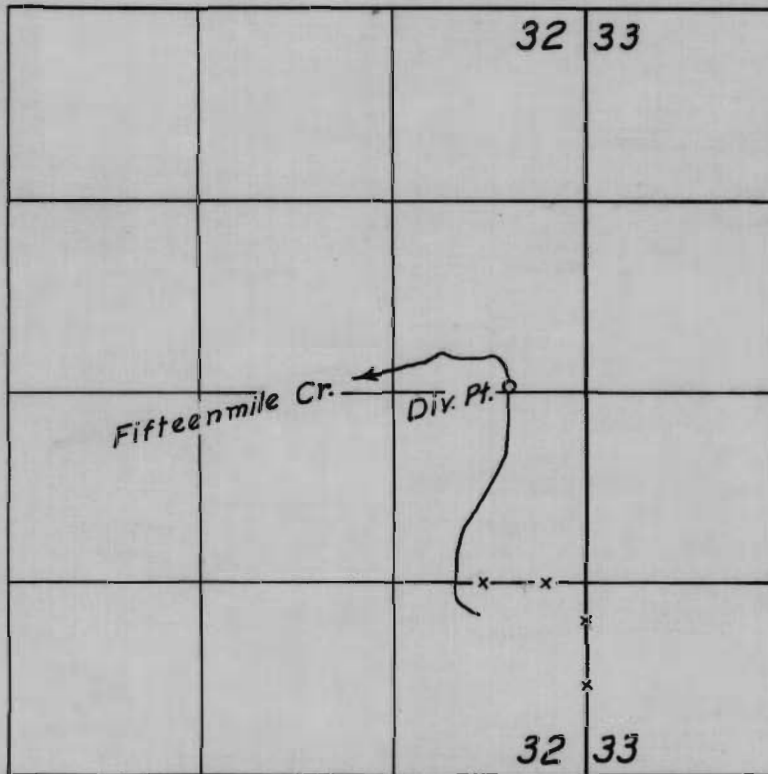

**FINAL PROOF SURVEY**  
UNDER

Application Transfer No. P-61.....  
IN NAME OF

..... *Geo. Petroff* .....

Surveyed April 5, 1962, by *L. W. Deboisek*