


T.4S.R.1E.W.M

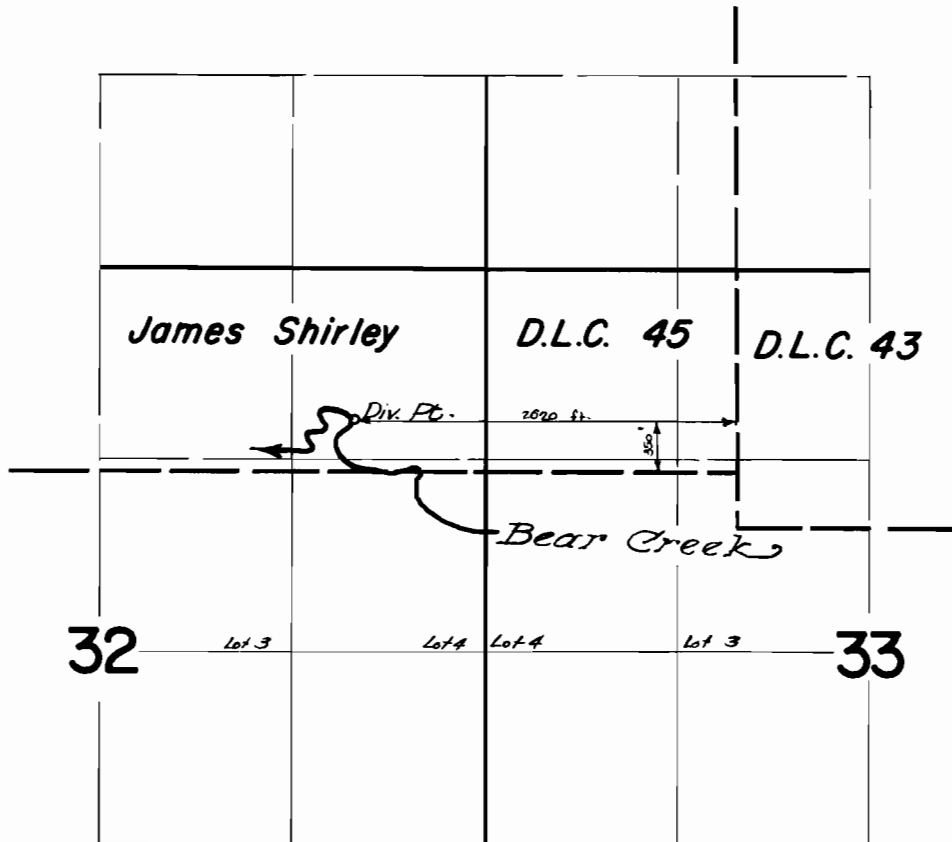

FINAL PROOF SURVEY UNDER

Transfer No. P-69

Application No. _____ Permit No. _____
IN NAME OF

JOHN L. & EVELYN M. PATTERSON

Surveyed April 10, 1965, by *[Signature]*