


26

T. 1 N., R. 1 & 2 W., W.M.

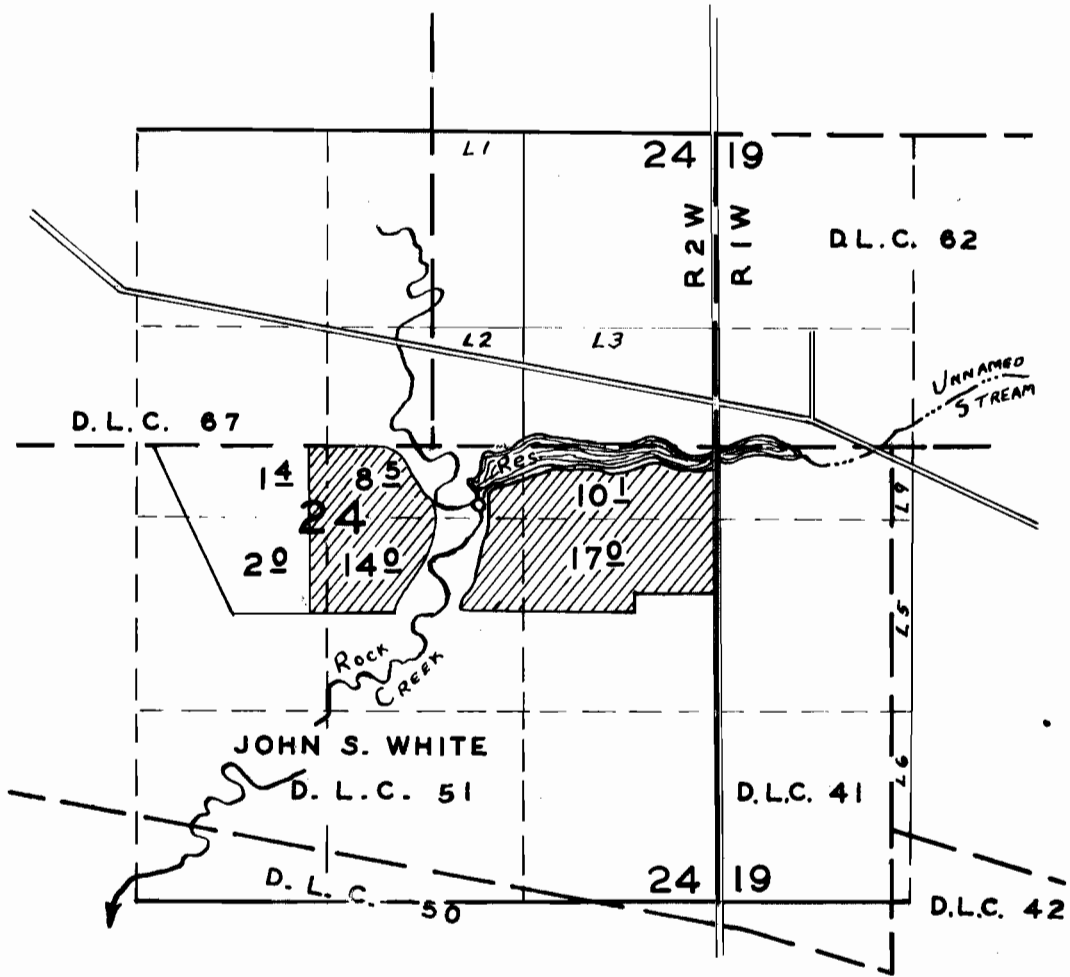

FINAL PROOF SURVEY

UNDER

R-25947

R-1216

Application No. 25948 Permit No. 20544

IN NAME OF

W. JEFFRIES

Surveyed 4 - 10 1956, by M. BISH