


T.17S.R.12E.W.M.

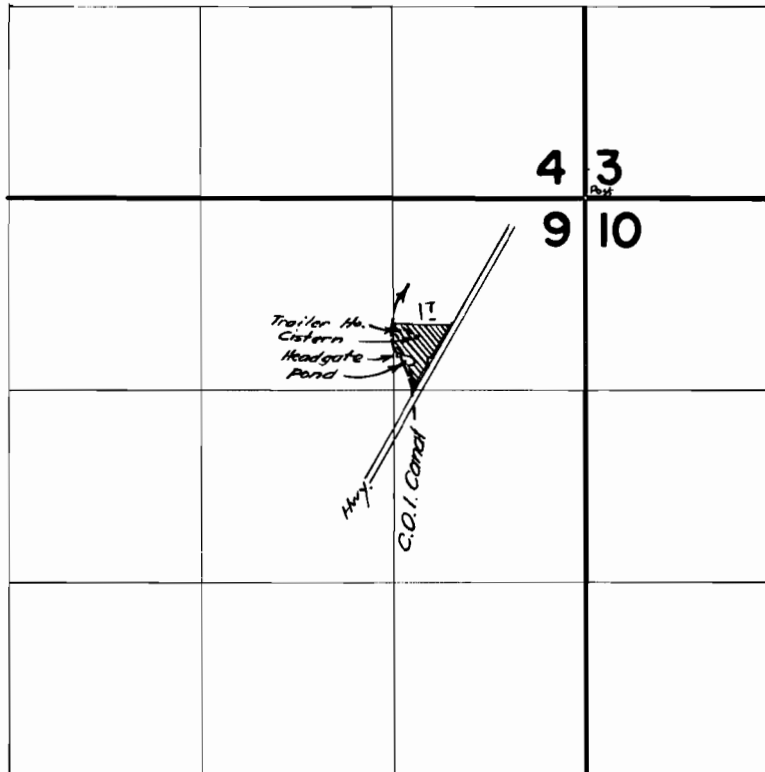

FINAL PROOF SURVEY UNDER

Transfer No. P-74

Application No. _____ Permit No. _____
IN NAME OF

O.L. Chapman

Surveyed *August 12, 1965*, by *A. Jackson*