


T. 2 N. R. 10 E. W. M.

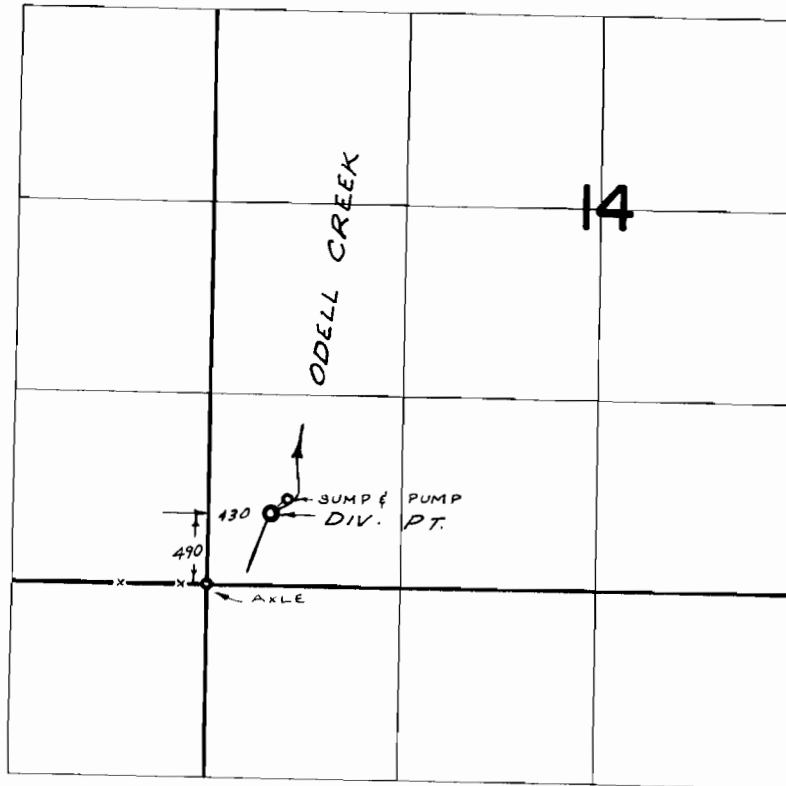

FINAL PROOF SURVEY
UNDER

TRANSFER NO. P-76

Application No. Permit No.

IN NAME OF

HARRY J. & EMILY A. PLOG

Surveyed APR. 22, 1971, by G. BACA