


T.39 S. R.8 W. W.M.

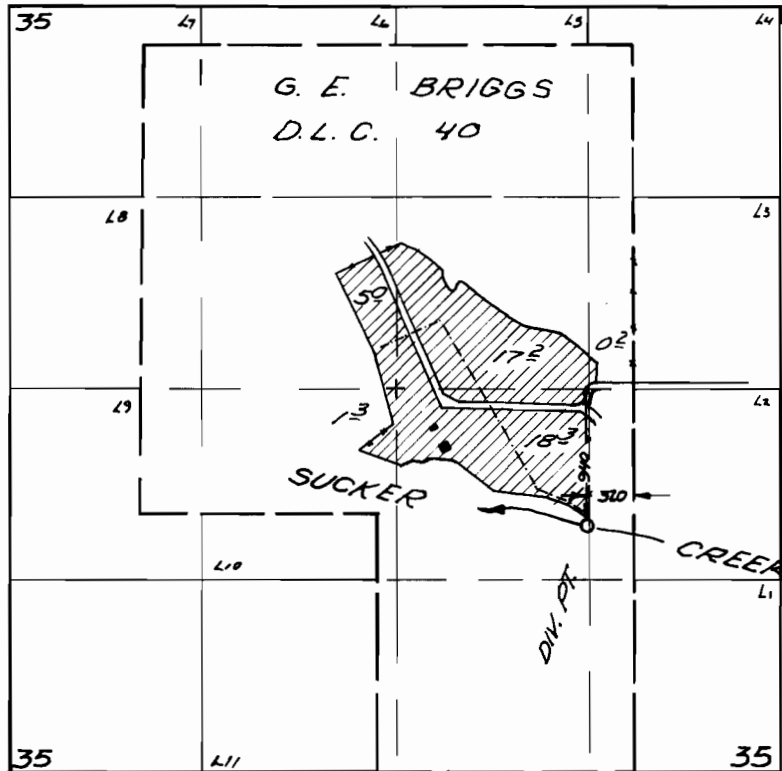

FINAL PROOF SURVEY
UNDER

TRANSFER P-79

Application No. Permit No.

IN NAME OF

ALVIN J. and EDITH V. PHILLIPS.

Surveyed *May 16, 1967,* by *V. Garner*