


T. 4 S. R. 4 0 E. W.M.

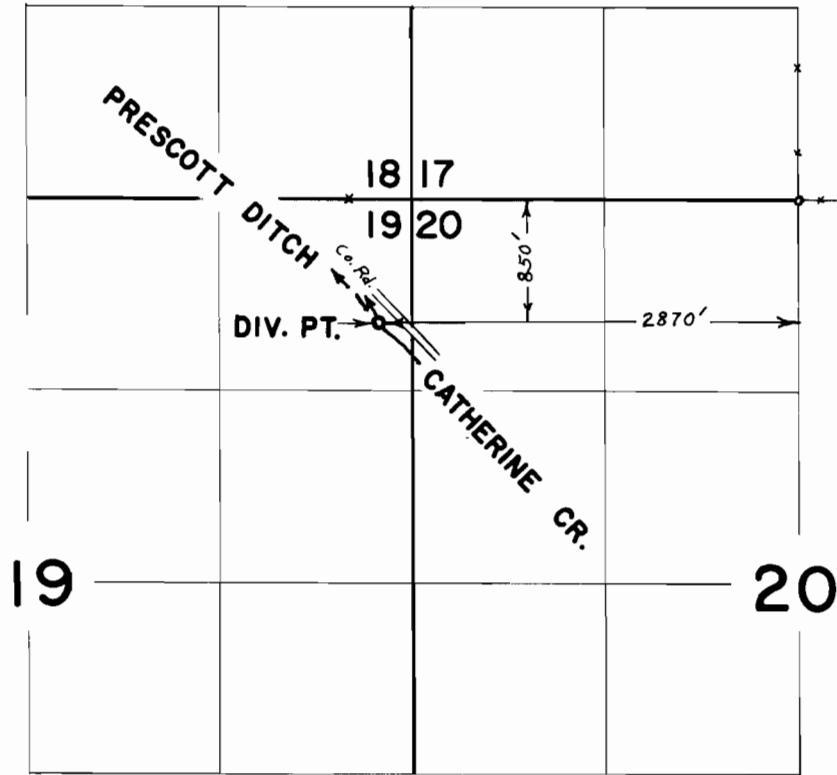

FINAL PROOF SURVEY
UNDER

TRANSFER NO. P.-80
Application No. Permit No.
IN NAME OF

PRESCOTT DITCH COMPANY

Surveyed Aug. 27, 1968, by L. E. Gould