


T.39S.R.7W.W.M.

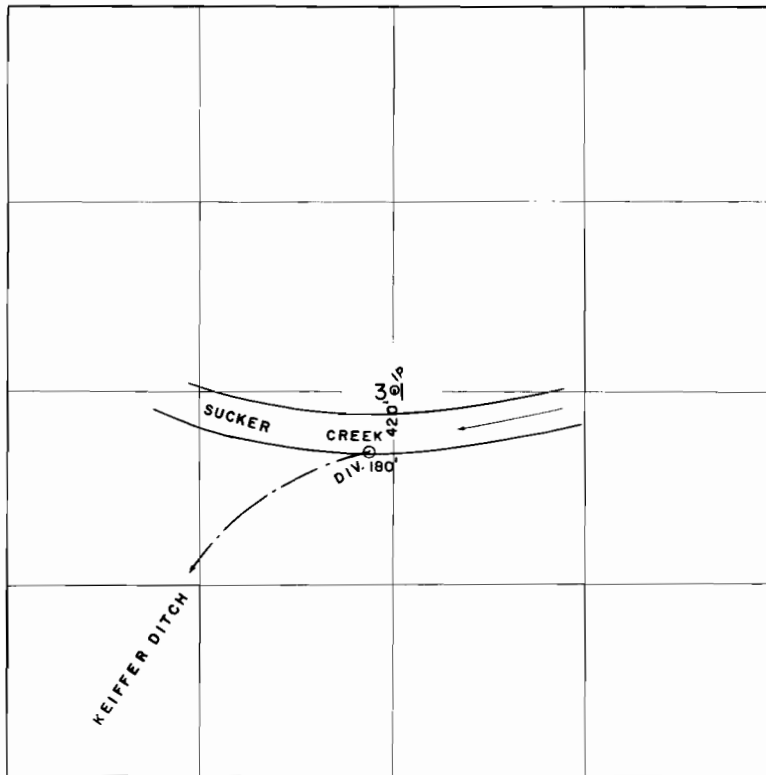

**FINAL PROOF SURVEY**  
UNDER

Application No. \_\_\_\_\_ <sup>TRANS</sup> Permit No. P-83 \_\_\_\_\_

IN NAME OF

PACIFIC VENTURES, INC.

Surveyed SEPT. 17, 1968, by R.B. STEIMER