


T.2N. R.15E. W.M.

LAYOUT APPEARS
TO BE WRONG -
LAND CONFORMS
TO PHOTO 41065
572-58

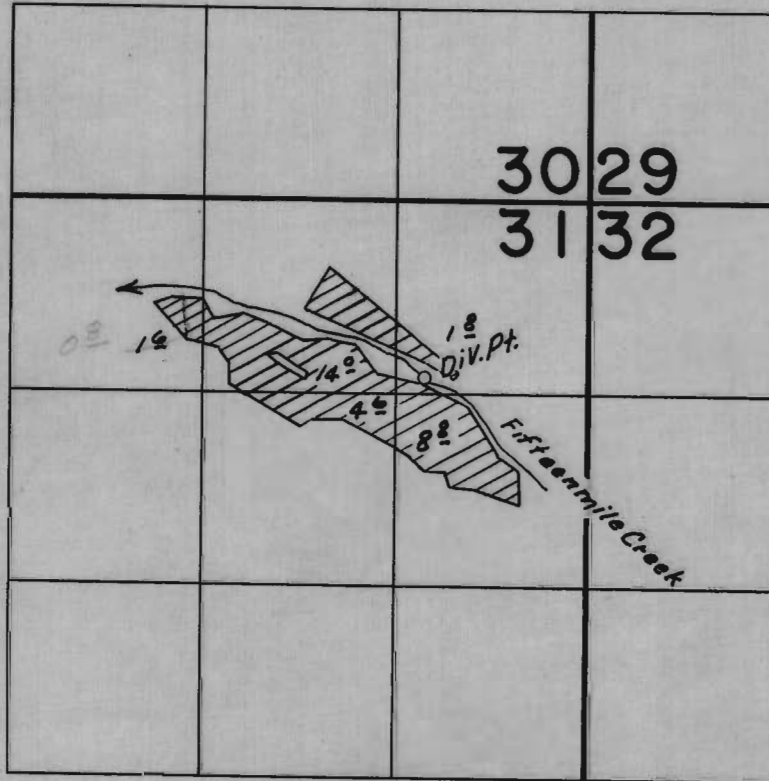

FINAL PROOF SURVEY
UNDER

Transfer No. Q-1 and Q-2

Application No. _____ Permit No. _____
IN NAME OF

CLARENCE E. QUIRK

Surveyed Oct. 19, 1964, by C.J. Gardner

Vol. 14, P. 313
Vol. 12, P. 354