


# T.2N.R.15E.W.M.

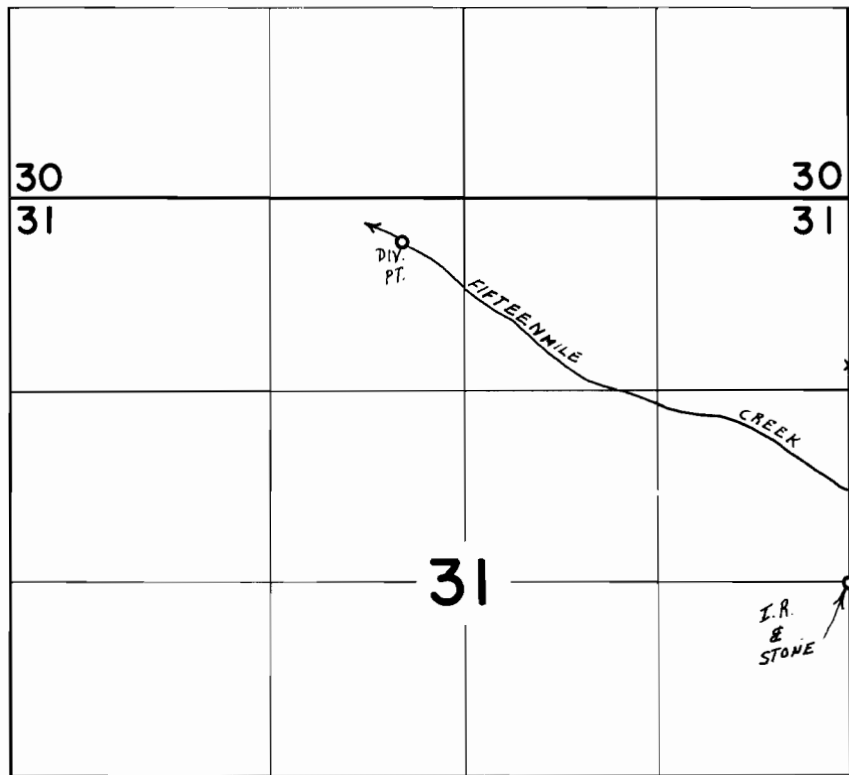

DIV. PT. LOC. 2350' N. & 3060' W. FROM E.  $\frac{1}{4}$  COR. SEC. 31

## FINAL PROOF SURVEY UNDER

TRANSFER NO. Q-4

Application No. \_\_\_\_\_ Permit No. \_\_\_\_\_

IN NAME OF

CLARENCE E. QUIRK

Surveyed OCT. 29, 1970, by L. E. GOULD