


T.3S.R.9W.W.M.

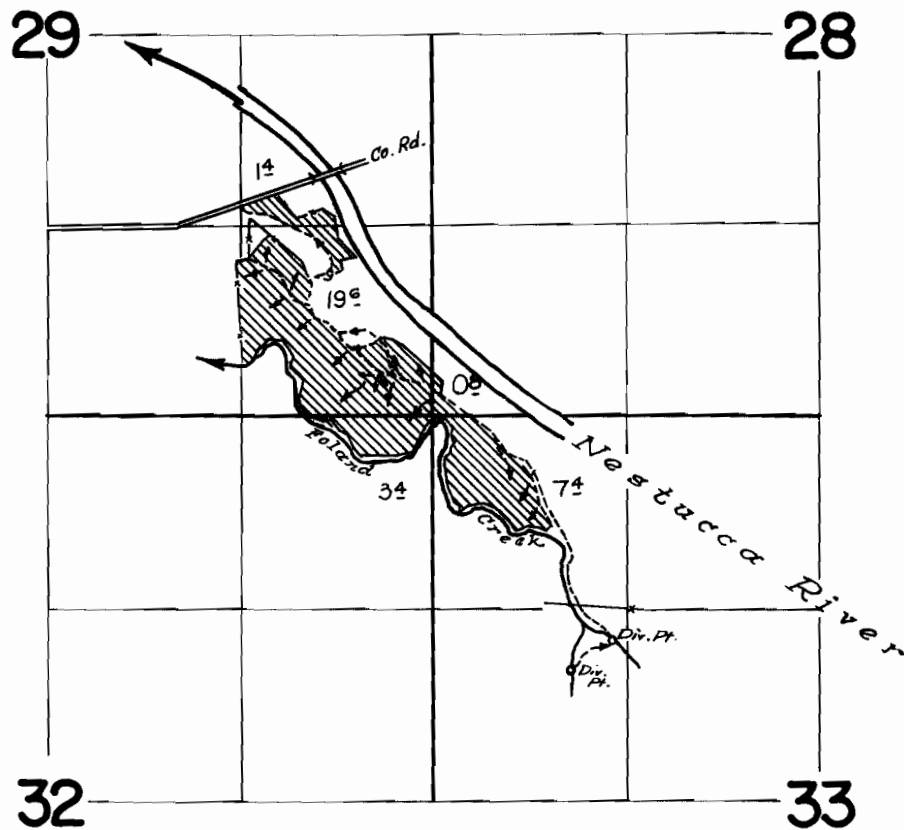

FINAL PROOF SURVEY UNDER

Transfer R-19

Application No. Permit No.

IN NAME OF

V. C. COLE

Surveyed August 1 1962, by *R. Jackson*