



NW 1/4 - SE 1/4 - SEC. 21 T514S. R13E

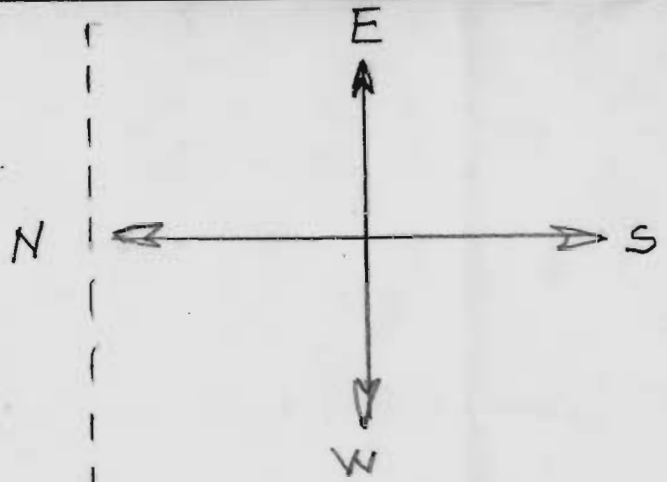

RECEIVED  
MAY 12 1952  
STATE ENGINEER  
SALEM, OREGON

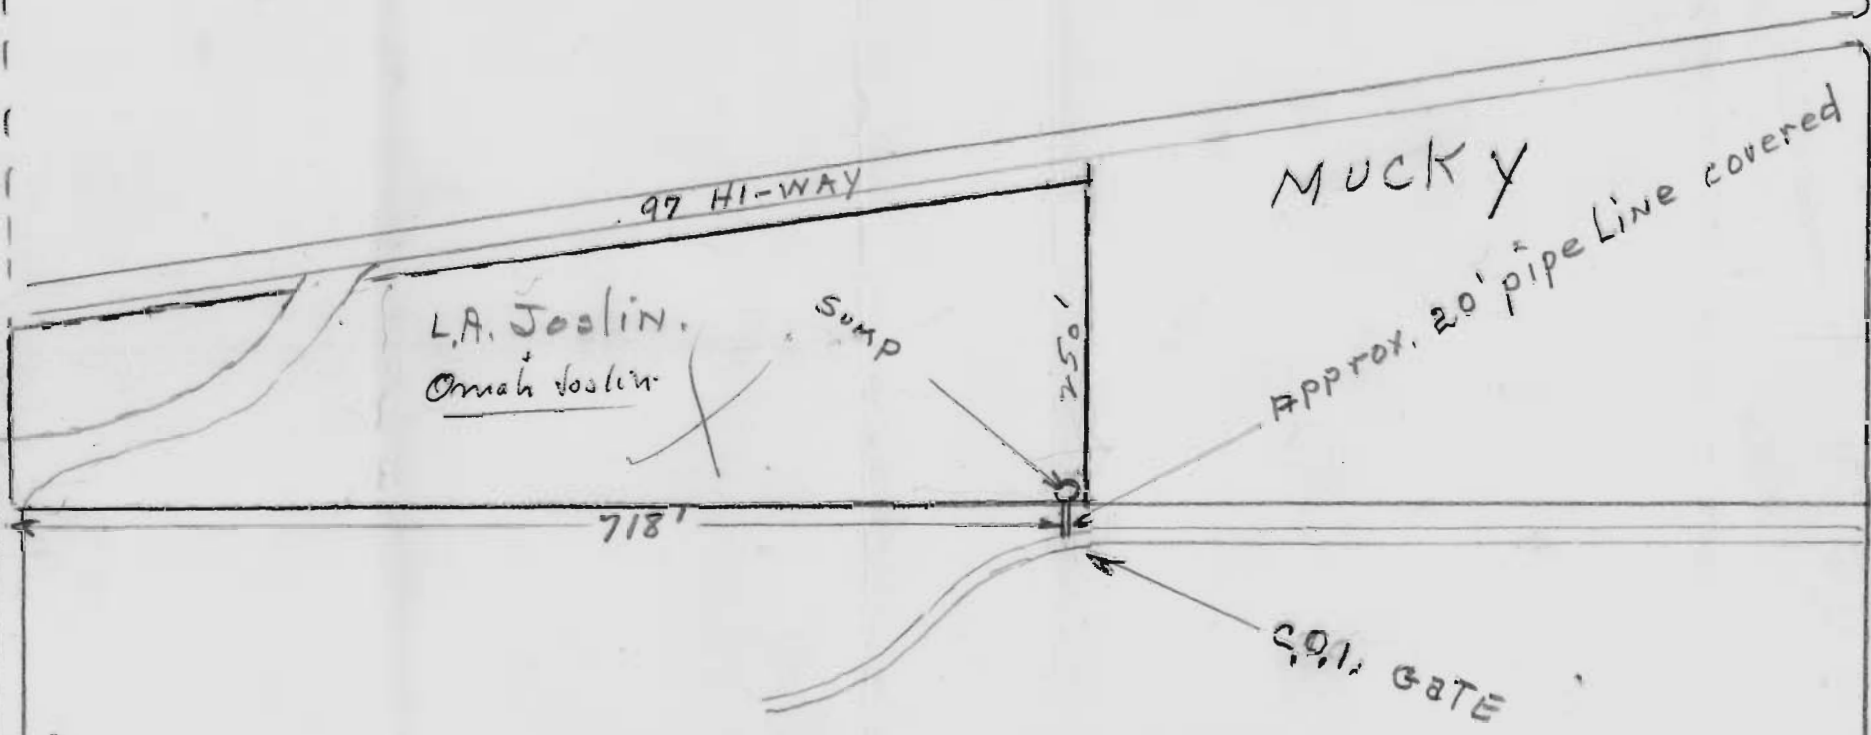

N 1/2 - SW 1/4 - S21 - T514S - R13E

John Magee  
Evelyn Magee.