


T. 2N. R. 30E. W.M.

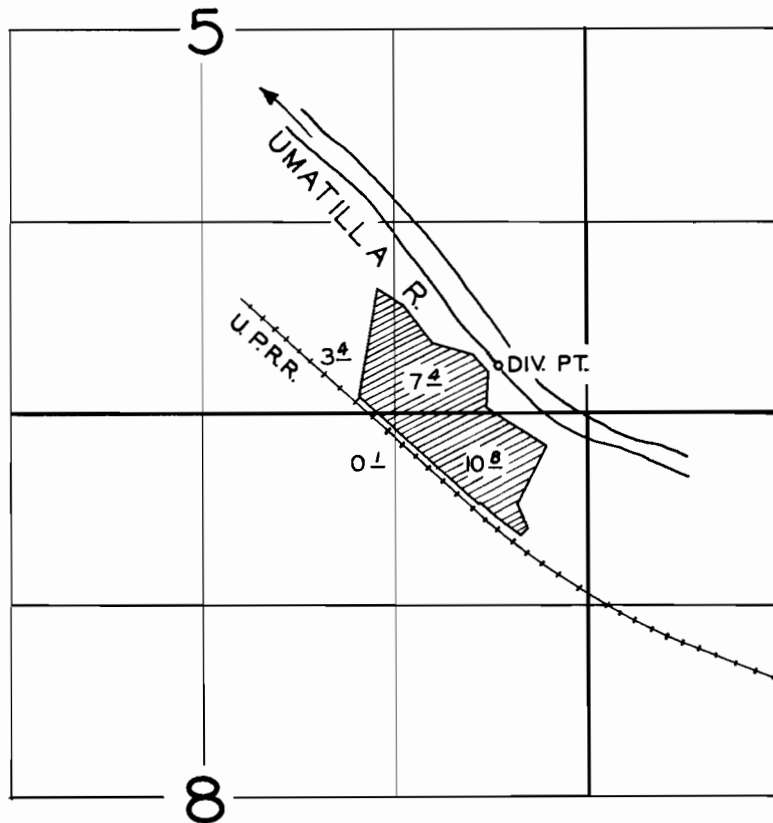

FINAL PROOF SURVEY
UNDER

Application No. 27476 Permit No. 21628
IN NAME OF

CUNNINGHAM SHEEP CO.

Surveyed JULY 21, 1960, by