


T.8S.R.3 W.W.M.

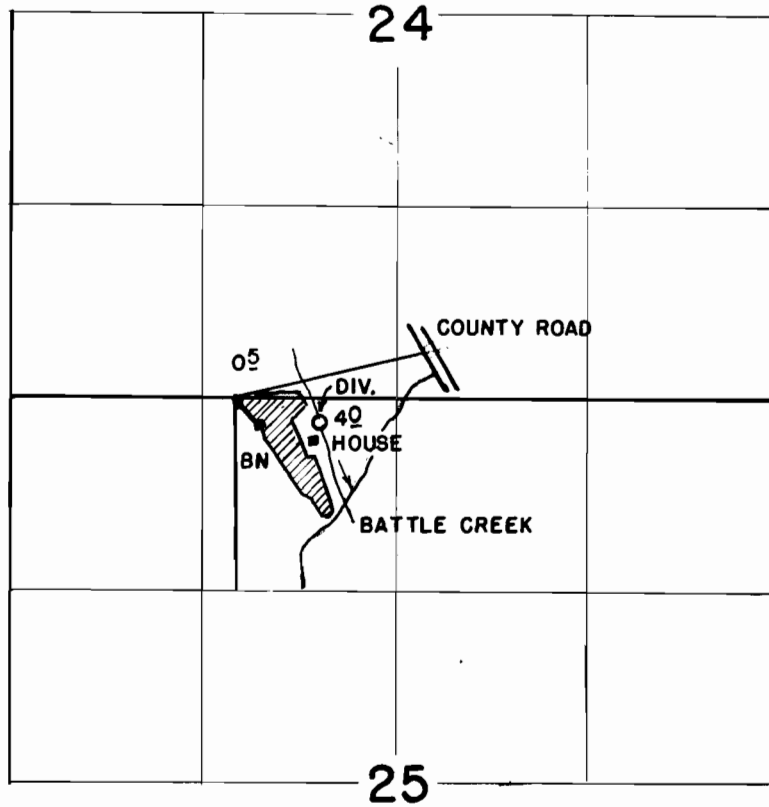

FINAL PROOF SURVEY
UNDER

Application No. R-61 Permit No.
IN NAME OF

WALTER J. SCHENDEL

Surveyed Oct. 24, 1962, by *Floyd L. Siegmund*