


T.13S., R.33E., W.M.

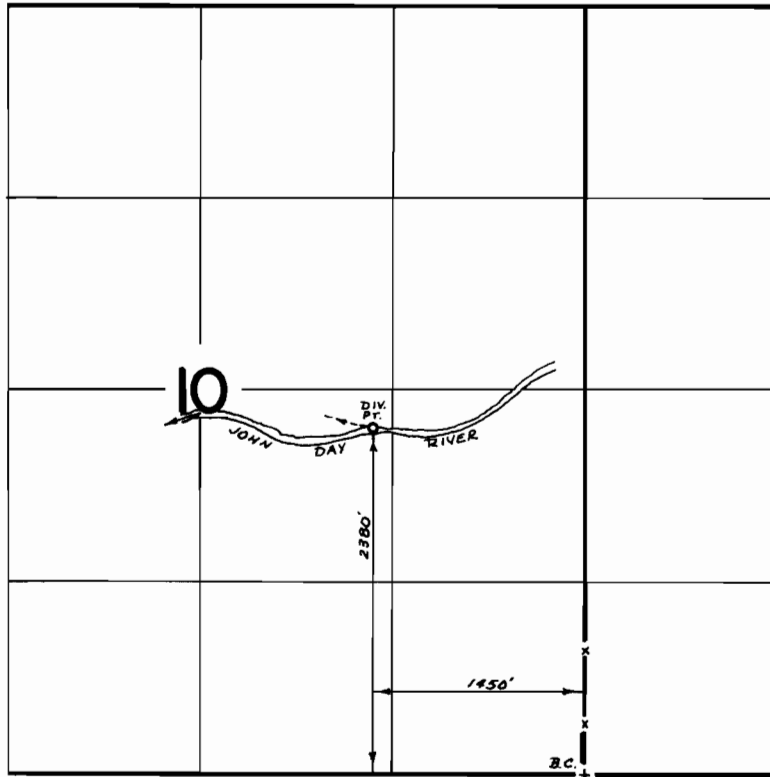

FINAL PROOF SURVEY
UNDER

Transfer No. R-67

Application No. Permit No.
IN NAME OF

..... *EUGENE RICCO*

Surveyed Aug. 7, 1972, by *D. Norby*