


T.13S. R.29E. W.M.

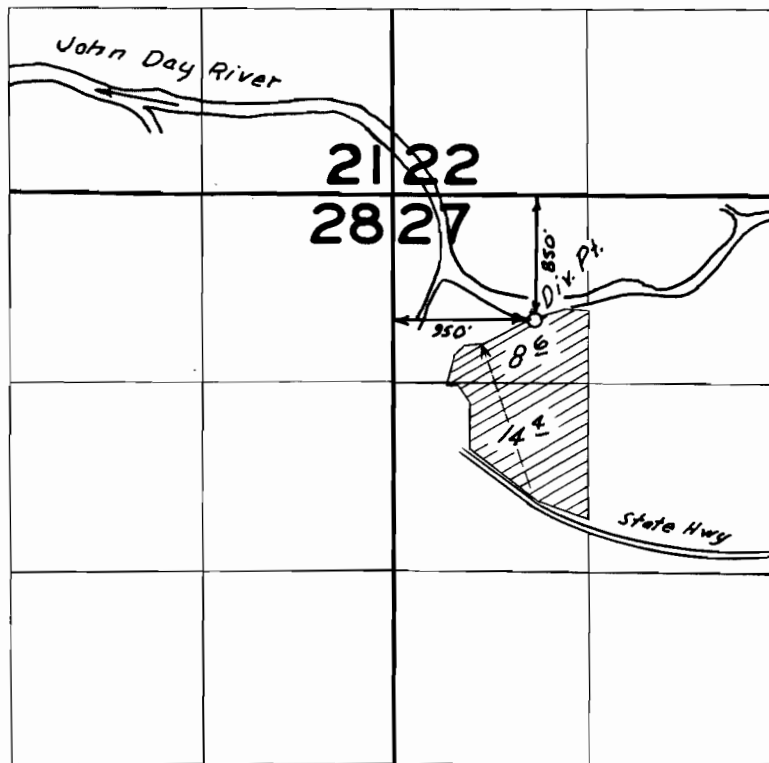

FINAL PROOF SURVEY
UNDER

Transfer R-70
Application No. _____ Permit No. _____
IN NAME OF

DONALD M. RIPA

Surveyed Oct. 26, 1964, by R. Jackson