


T. 36S. R. 4 W. W.M.

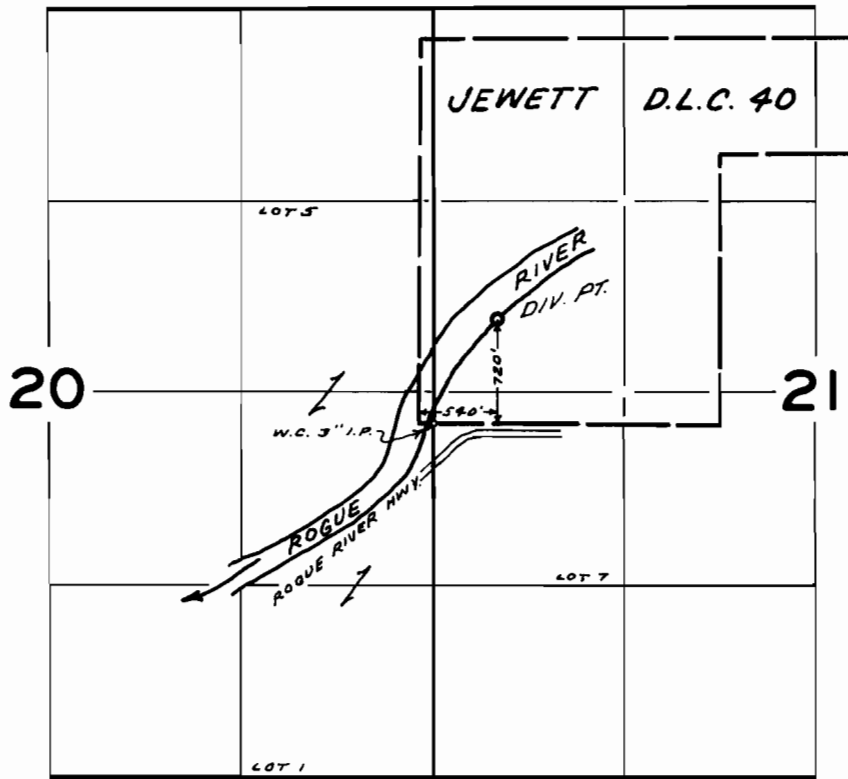

FINAL PROOF SURVEY
UNDER

TRANSFER No. R-93
Application No. _____ Permit No. _____
IN NAME OF

GERALDINE H. REAMBEAULT

Surveyed JUN 4 1968, by V. GARNER