




# T.1N.R.4W.W.M.

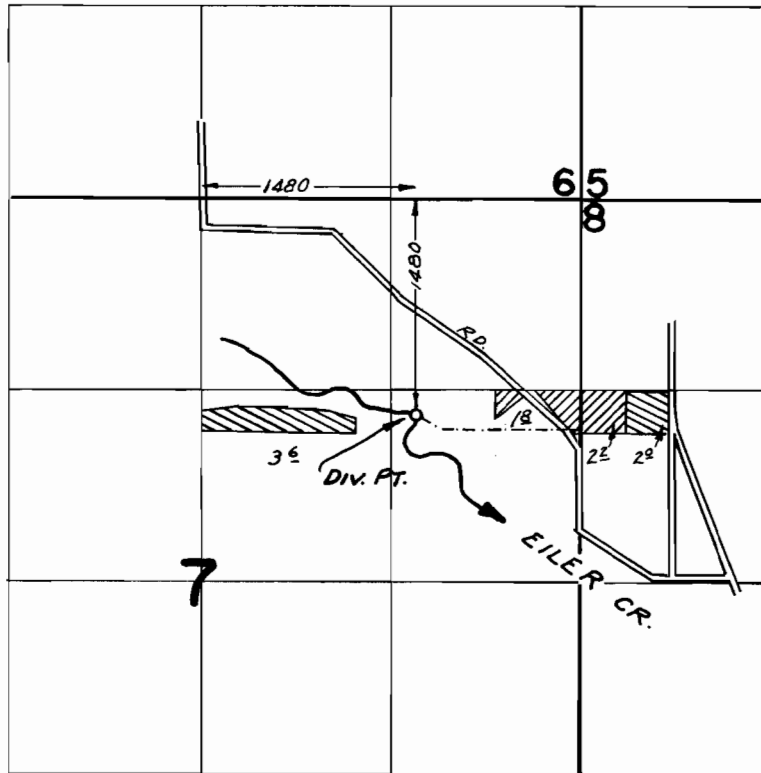

 LAND TRANSFERRED  
 LAND NOT TRANSFERRED

## FINAL PROOF SURVEY UNDER

TRANSFER NO. R-94  
Application No. .... Permit No. ....  
IN NAME OF

LONGFORD-HAMILTON CORPORATION

Surveyed NOV. 5, 1974, by R. MUGGEN