


SW 1/4 SE 1/4 SEC 16 T 15 S. R. 13 E W M

15 13 16DC

DESCHUTES COUNTY

SCALE 1" = 100'

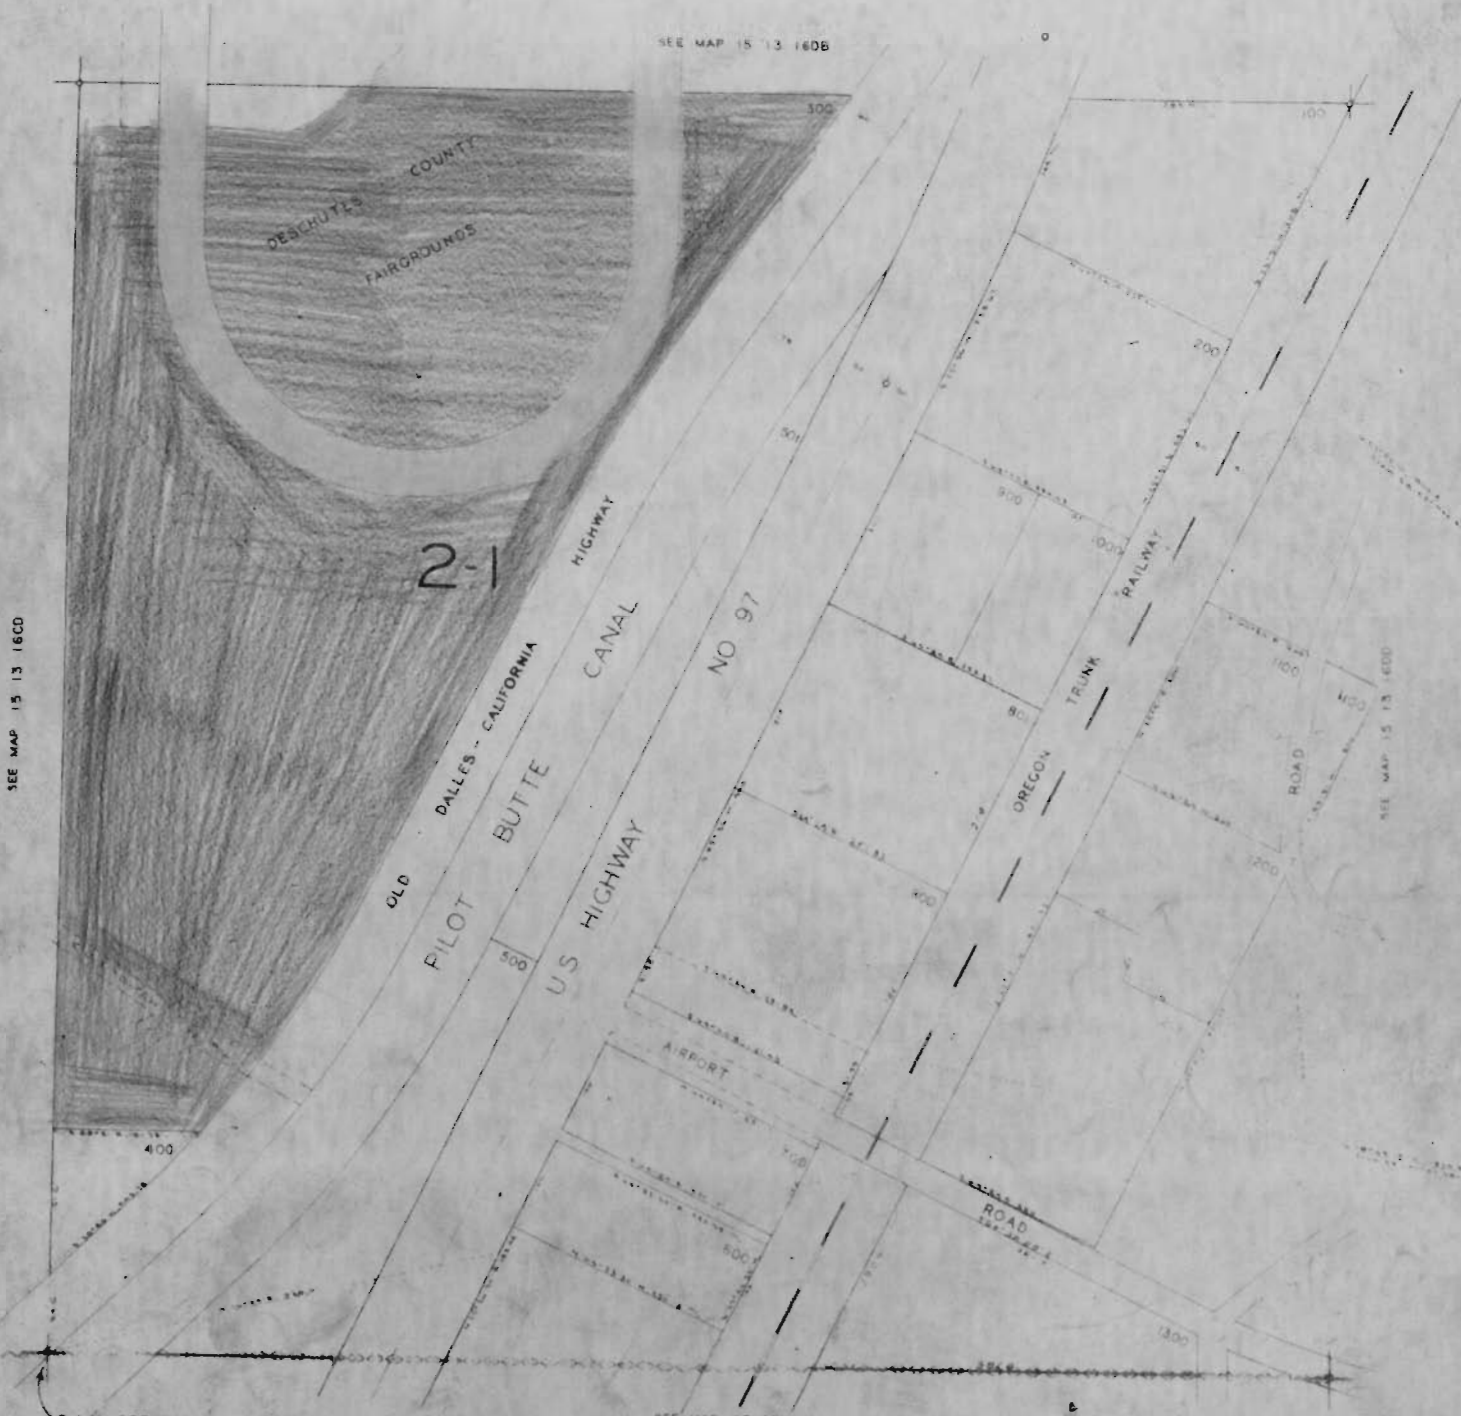

SEE MAP 15 13 1600

SEE MAP 15 13 160B

SEE MAP 15 13 1600

SEE MAP 15 13 21A

S 1/4 CORNER
SEC 16

*For Deschutes County Fair Assn.
 40 W. R. Grayfield
 632 So. Va. - Redmond, Ore.*

15 13 16DC
RECEIVED
 MAY 17 1967
 STATE ENGINEER
 FALL M. OREGON

DESCHUTES COUNTY

SCALE 1" = 100'

See Map 15 13 16AC

CENTER OF SEC 16

73
REDMOND

TOWNSHIP

REDMOND

STANDARD

ADDITION

SEE MAP 15 13 16CA

SEE MAP 15 13 16DA

STANDARDS

ARENA

DESCHUTES COUNTY

PA BARCELONIS

SEE MAP 15 13 16DA