


T.34S. R.1W. W.M.

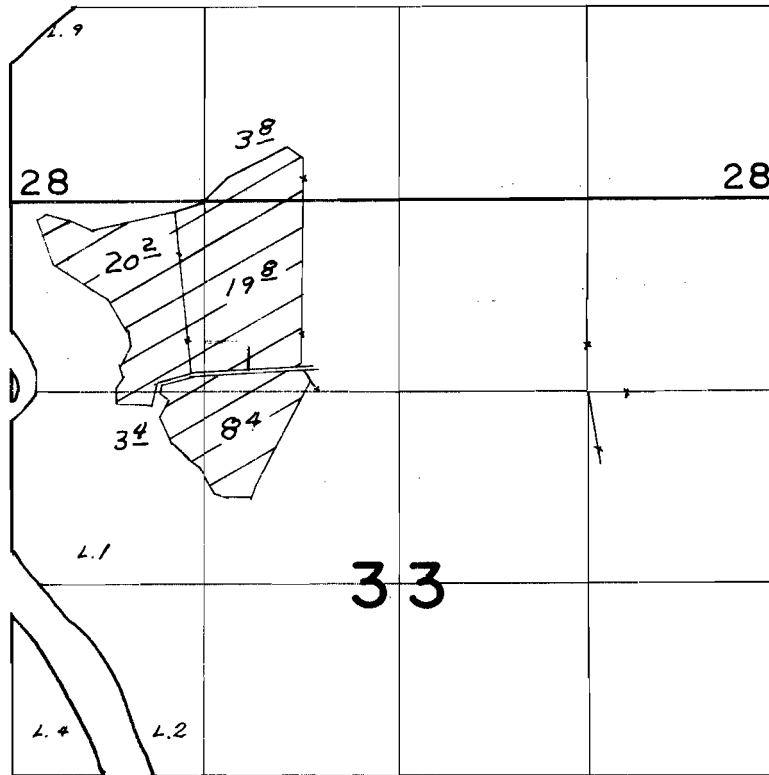

FINAL PROOF SURVEY UNDER

Transfer No. R-108
Application No. Permit No.
IN NAME OF

GINGER ROGERS

Surveyed APR. 26 1975, by L.H. NUNN.....