


T.36S., R.1W., & R.2W., W.M.

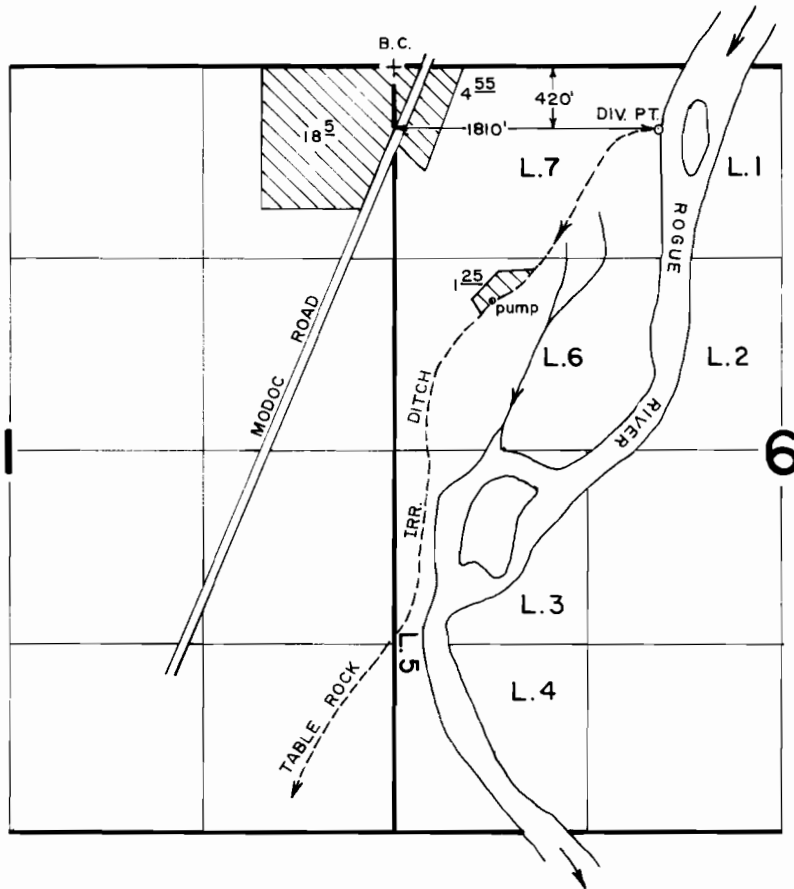

FINAL PROOF SURVEY
UNDER

TRANSFER NO. R-121

Application No. Permit No.

IN NAME OF

RAY W. & JEAN S. RYAN & MABEL C. PATTERSON

Surveyed FEB. 4, 1983, by B. S. JAMES

SCALE: 4" = 1 MILE

1963 A
BAX-3AA-92 TWB