


I, WAYNE O. HARRIS, REGISTERED OREGON LAND SURVEYOR #346, DO HEREBY CERTIFY THAT THIS MAP WAS MADE BY ME FROM NOTES TAKEN DURING AN ACTUAL SURVEY BY ME ON THE 12TH DAY OF MARCH, 1964, THAT THE MONUMENT SHOWN ON THE MAP IS A 2" IRON PIPE AT THE WEST 1/4 CORNER OF SECTION 27, T. 2 N., R. 27 E., W.M.

Wayne O. Harris
WAYNE O. HARRIS

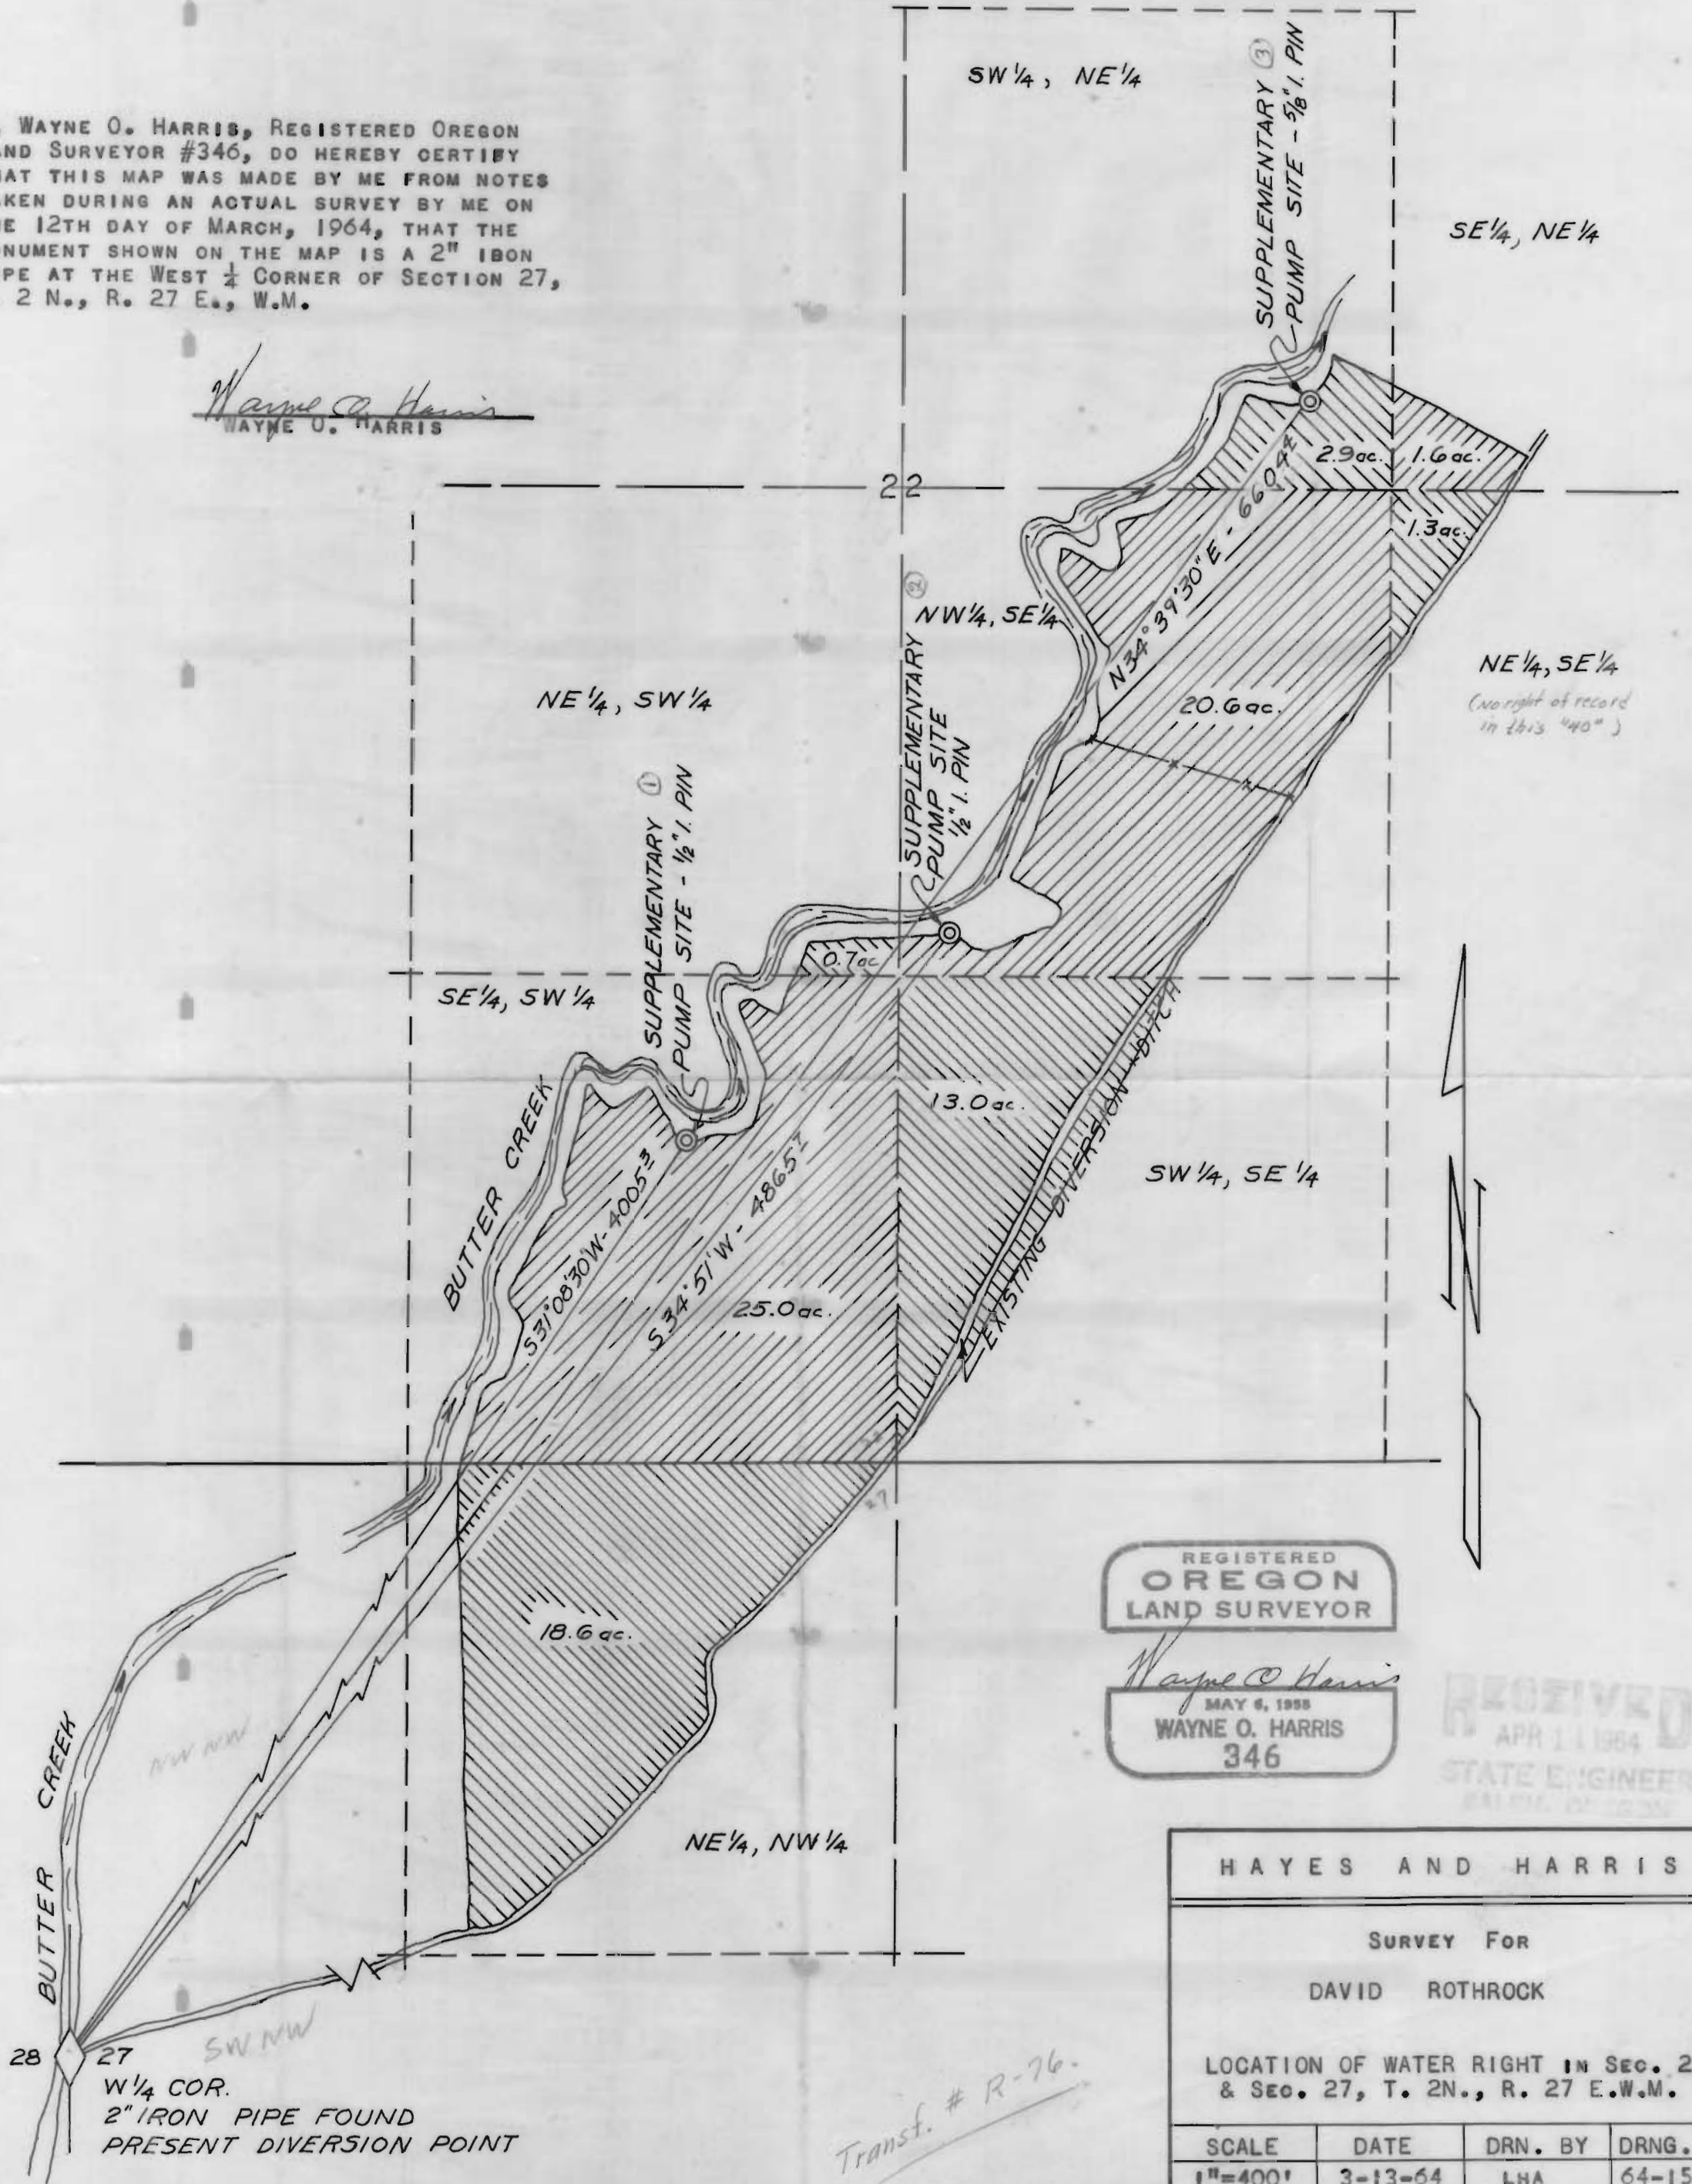

REGISTERED
OREGON
LAND SURVEYOR

Wayne O. Harris
MAY 6, 1958
WAYNE O. HARRIS
346

RECEIVED
APR 11 1964
STATE ENGINEER

HAYES AND HARRIS			
SURVEY FOR DAVID ROTHROCK			
LOCATION OF WATER RIGHT IN SEC. 22 & SEC. 27, T. 2 N., R. 27 E. W.M.			
SCALE	DATE	DRN. BY	DRNG. NO.
1"=400'	3-13-64	LHA	64-152-A

Transf. # R-76.