


T.4S. R.1W. W.M.

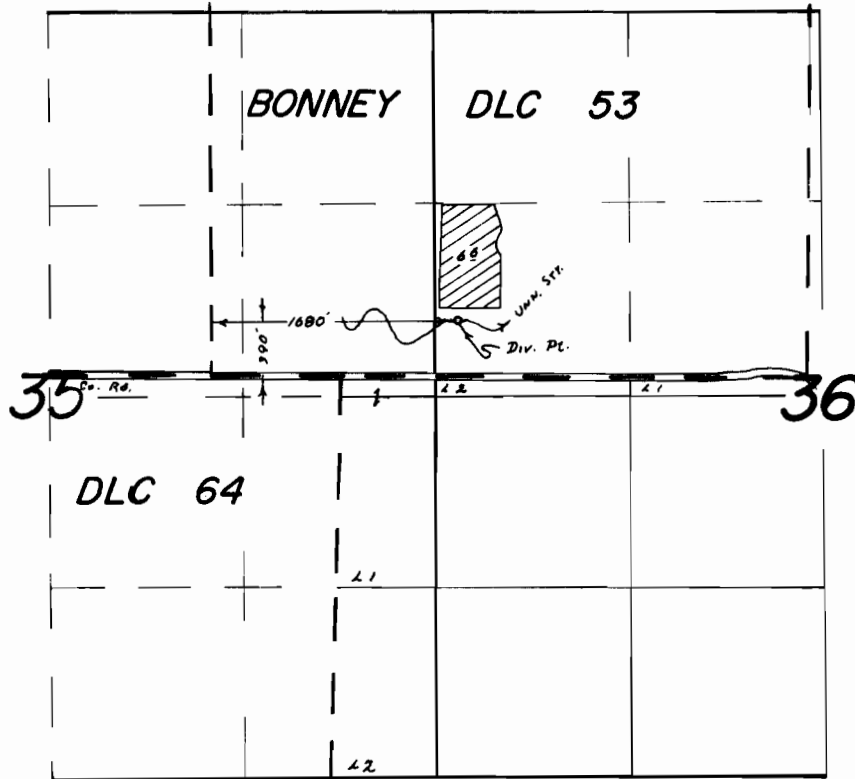

FINAL PROOF SURVEY
UNDER

transfer No. S 209
Application No. 42807 Permit No. 33790
IN NAME OF

WM. N. STRUBHAR

Surveyed JUNE 5 1973, by R. G. MUCKEN
Sept. 6, 1977, by B. R. SUND