


SECTION

— acreage ~~being~~ desired water right } 1895
— " transferred to

TOWNSHIP _____, RANGE _____, W. M. } 1904

— acreage desired right }
— " transferred North to

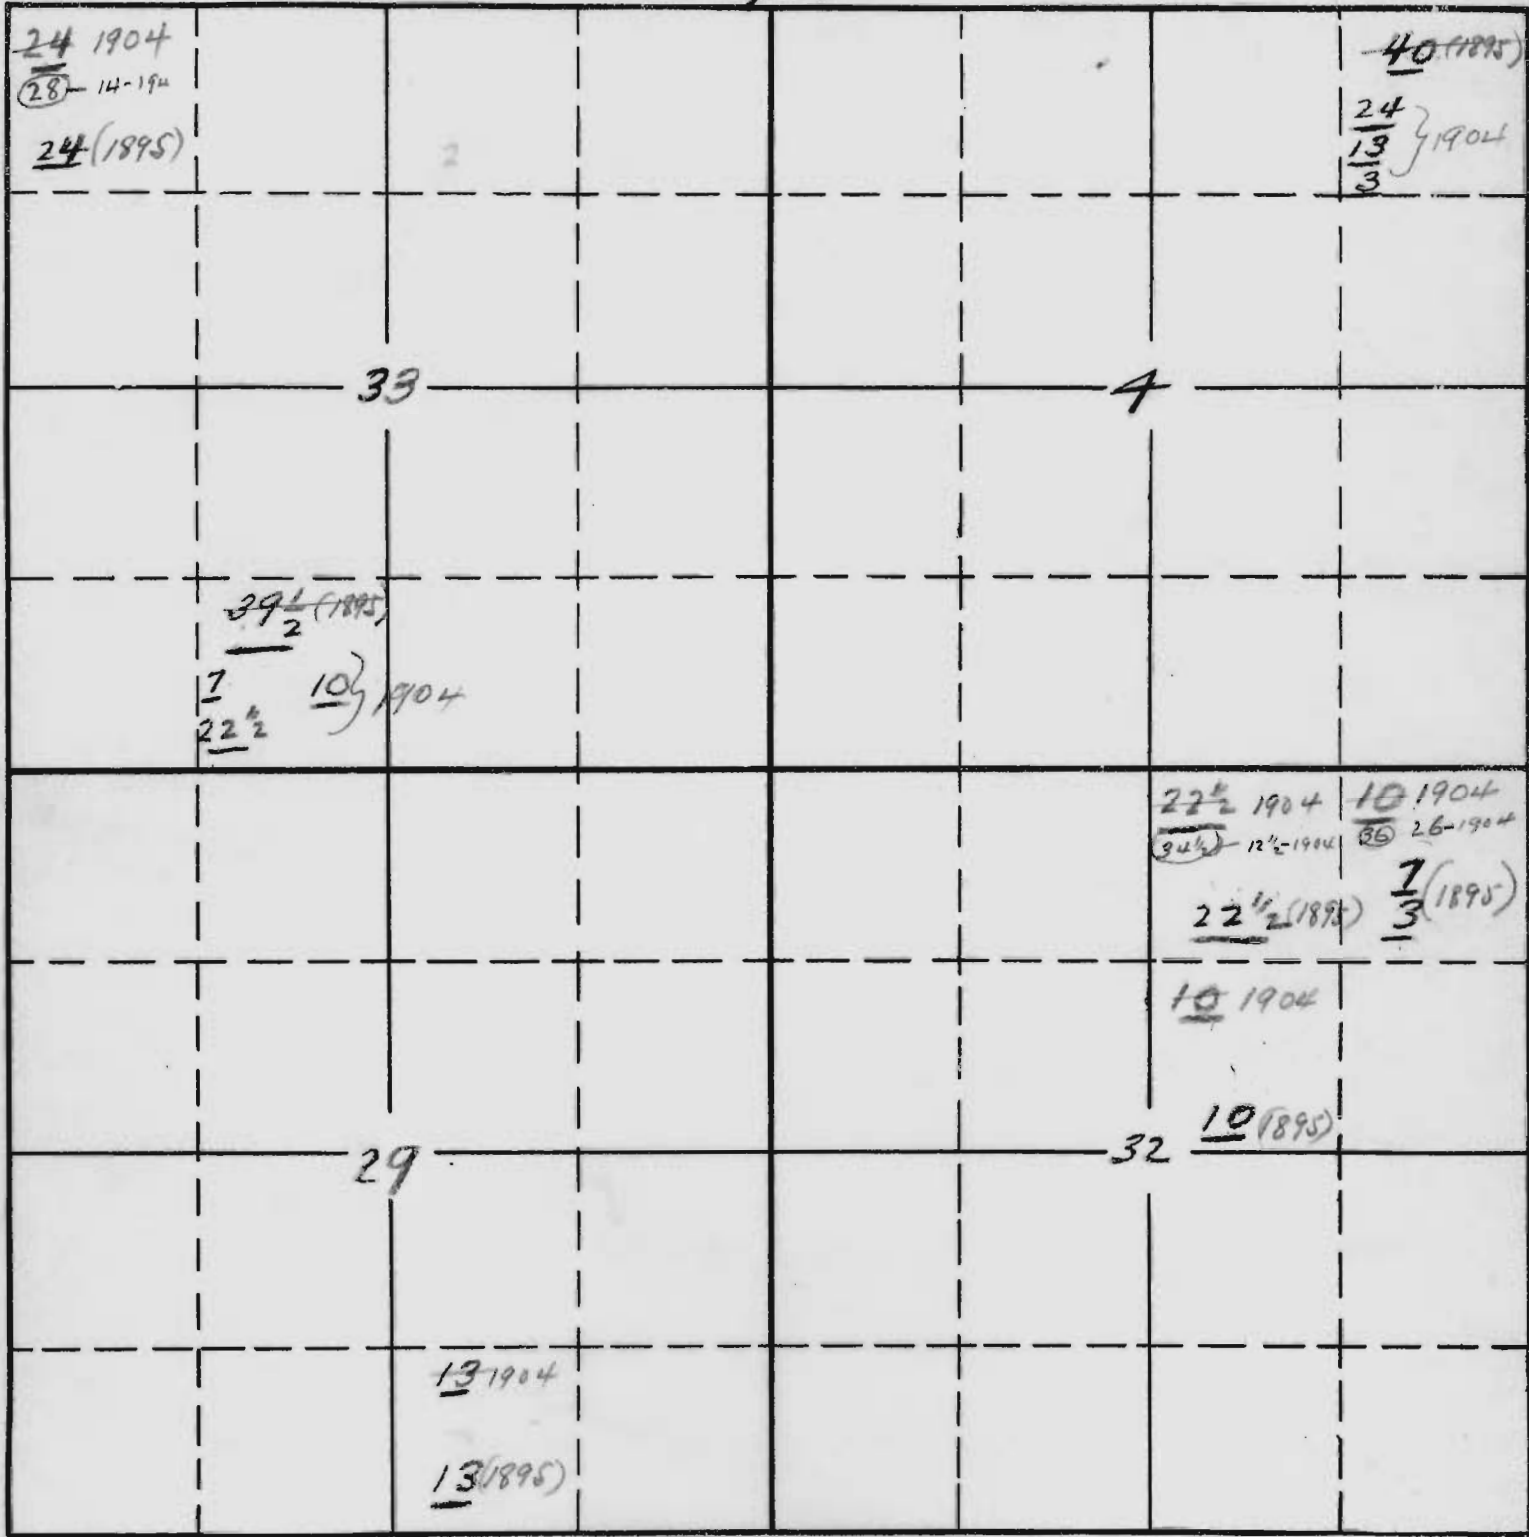

South

APPLICATION No.

PERMIT No.