


T.2S. R.44E. W.M.

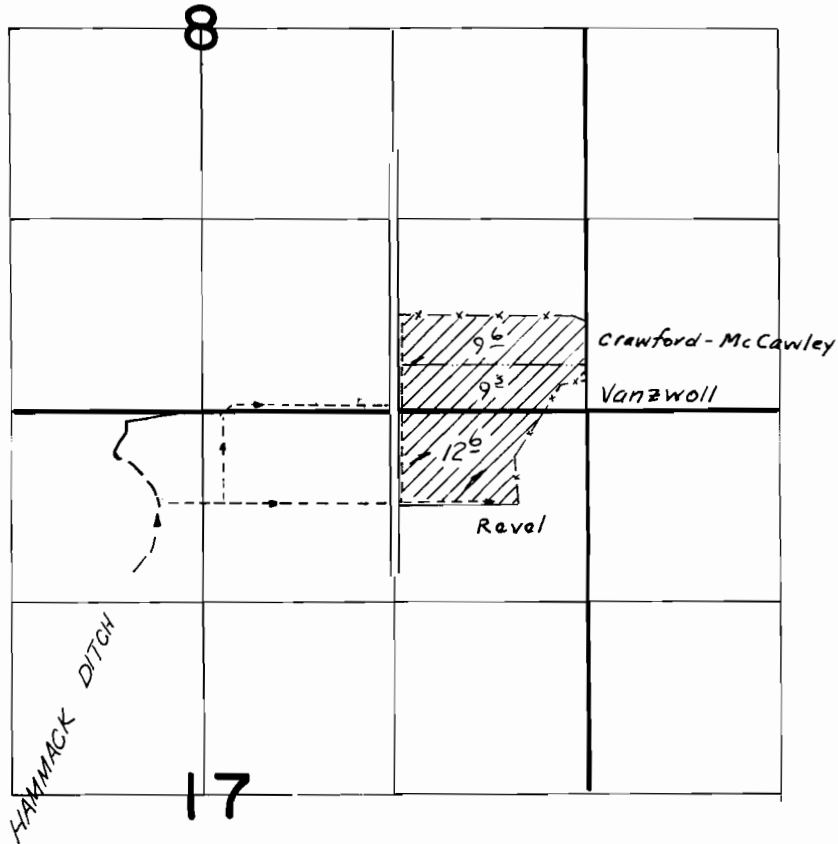

FINAL PROOF SURVEY
UNDER

TRANSFER NO S-27

Application No. Permit No.

IN NAME OF

Wayne L. Vanzwoll,
Robert A. Crawford, & Art D. Rebel

June 24, 1966

Surveyed 19, by V. GARNER

AUG. 17, 1981 V. CHURCH