


T. 5 S. R. 12 E. W.M.

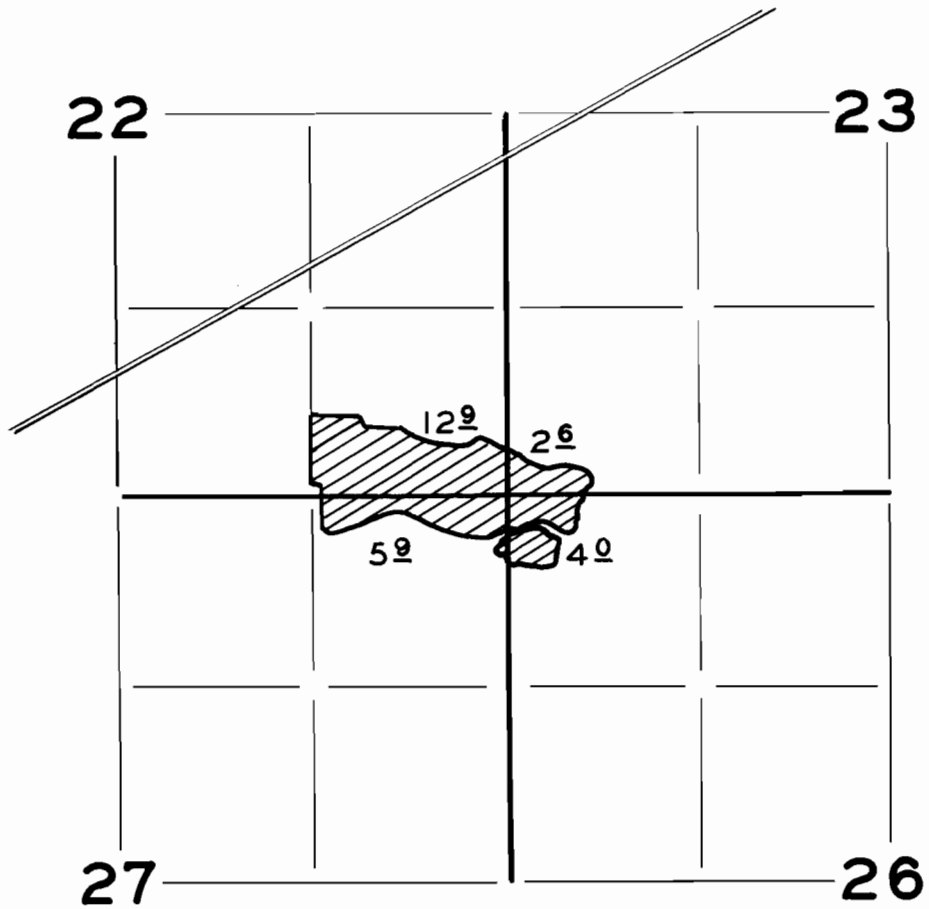

FINAL PROOF SURVEY
UNDER


TRANSFER: S-62

IN NAME OF

LLOYD T. & LORRAINE S. WOODSIDE

Surveyed OCT. 3, 1960, by W. CARR

T.5 S. R. 12 E. W.M.

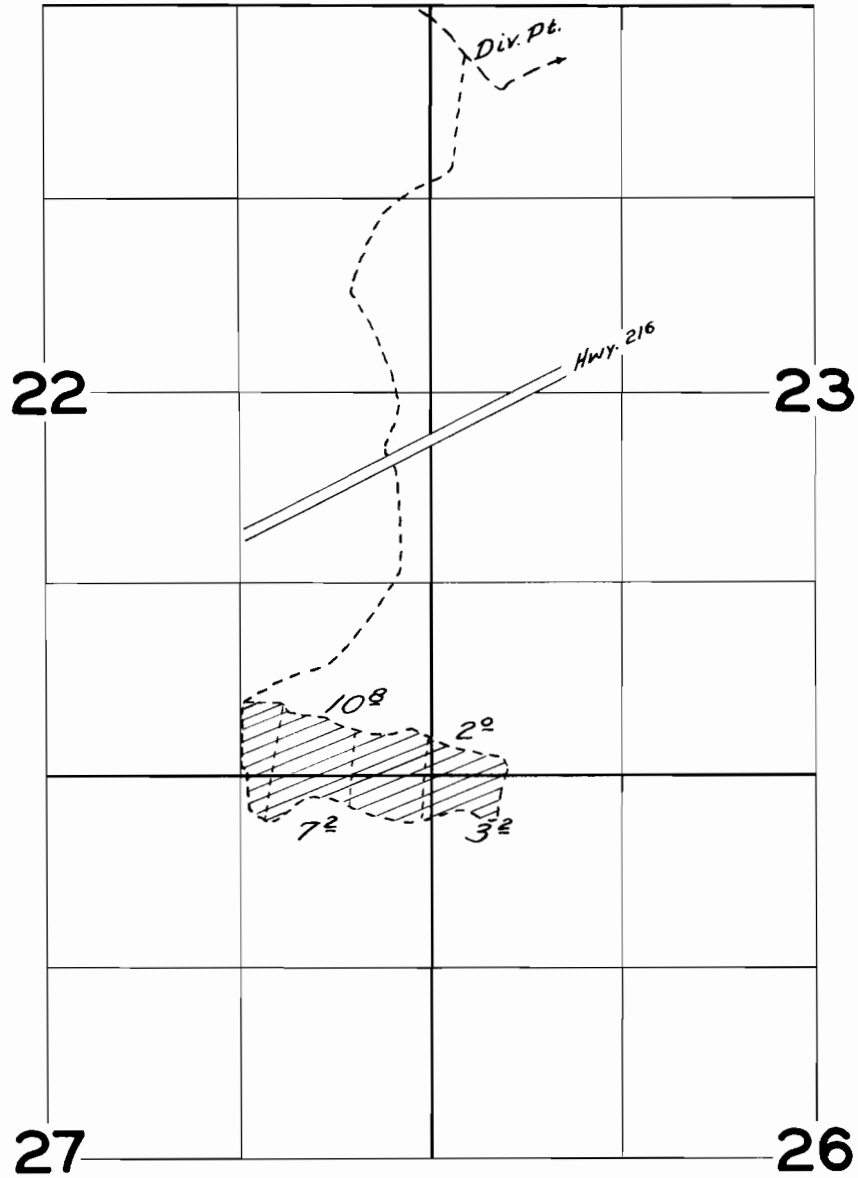

FINAL PROOF SURVEY
UNDER

Transfer No. 5-62

IN NAME OF

Lloyd T. & Lorraine S. Woodside

Surveyed *Oct. 14, 1957*, by *C. O. Baile*