


T.4S.R.39E.W.M.

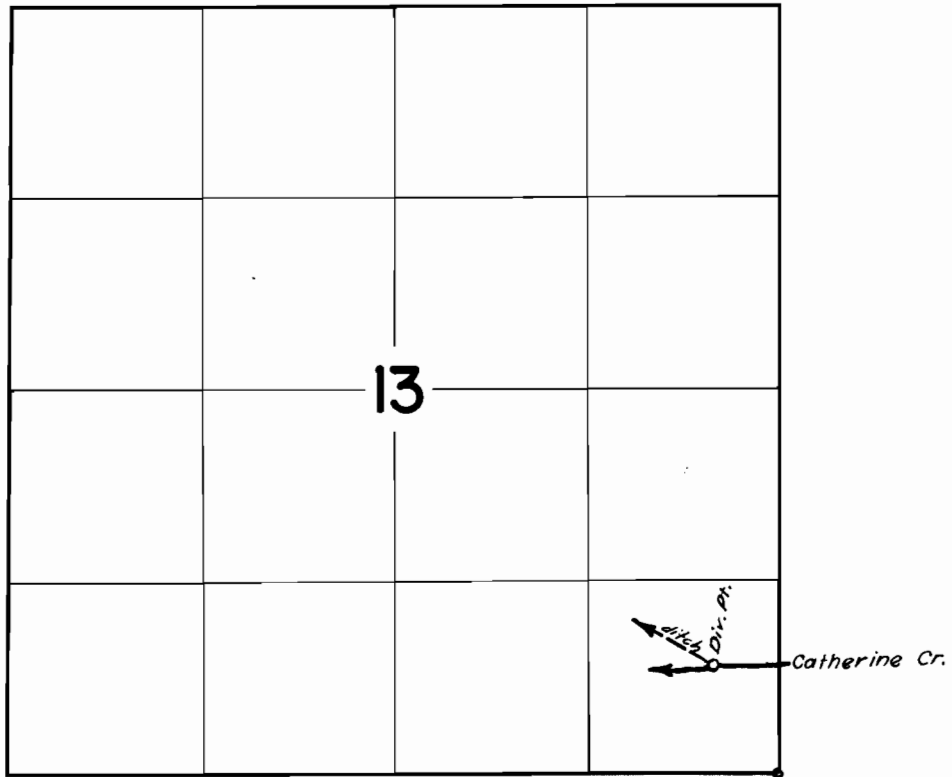

Div. Pt. Loc: 710' N. & 400' W. from SE Cor. Sec. 13

FINAL PROOF SURVEY UNDER

Transfer S-65

Application No. Permit No.
IN NAME OF

FORREST SCROGGIN

Surveyed Sept. 24 1963, by C. R. Baker.