


MAP TO ACCOMPANY
 APPLICATION FOR CHANGE OF
 POINT OF DIVERSION
 AND USE
 SCHOOL DISTRICT No. 3C - TUMALO - OREGON.

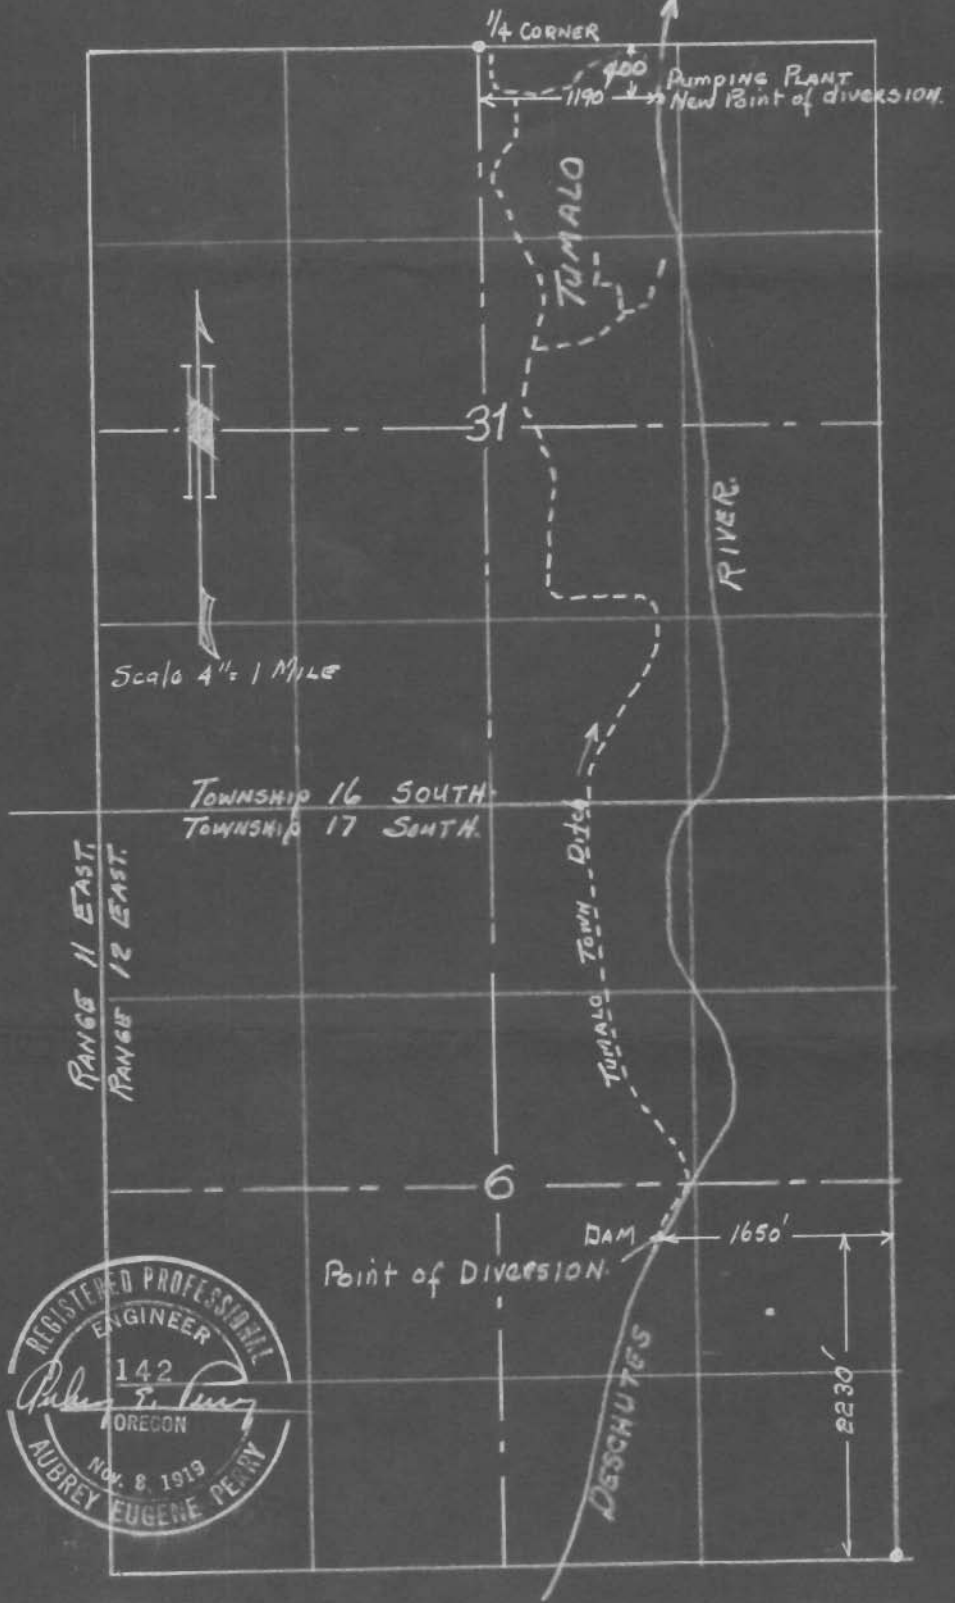



MAP TO ACCOMPANY
APPLICATION FOR CHANGE OF
POINT OF DIVERSION
AND USE
SCHOOL DISTRICT No 30 - TUMALO - OREGON.

DETAIL MAP

Sec. 30
1/4 CORNER.
Sec. 31 - Tp. 16 S. R. 12 E.

1170' EAST

