


T.5S.R.12E.W.M.

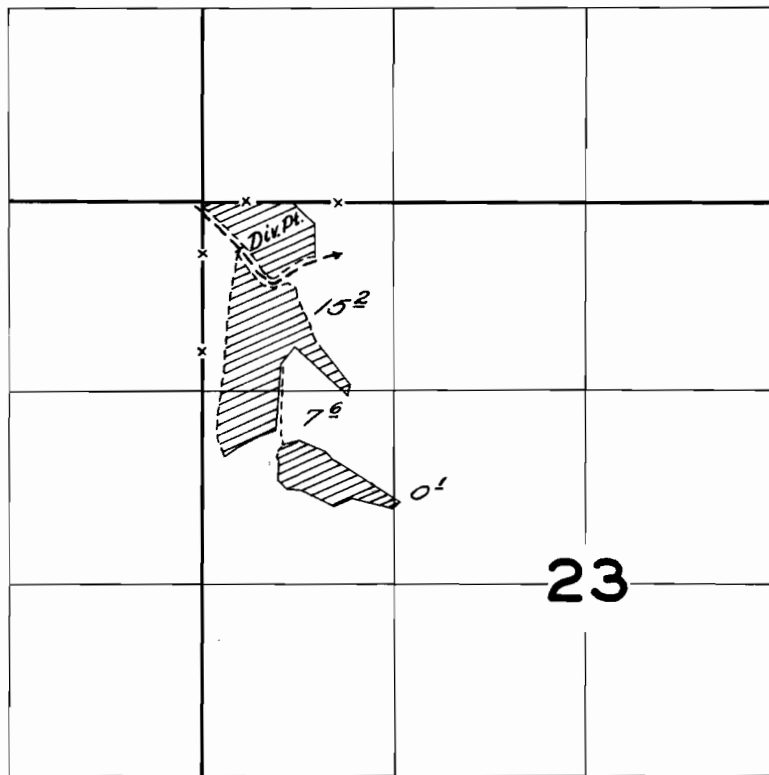

FINAL PROOF SURVEY  
UNDER

Transfer No. 5-91  
IN NAME OF

Lloyd Claymier

Surveyed Oct. 9 1957, by C.O. Bartels