


T.39 S.R.10 E.W.M.

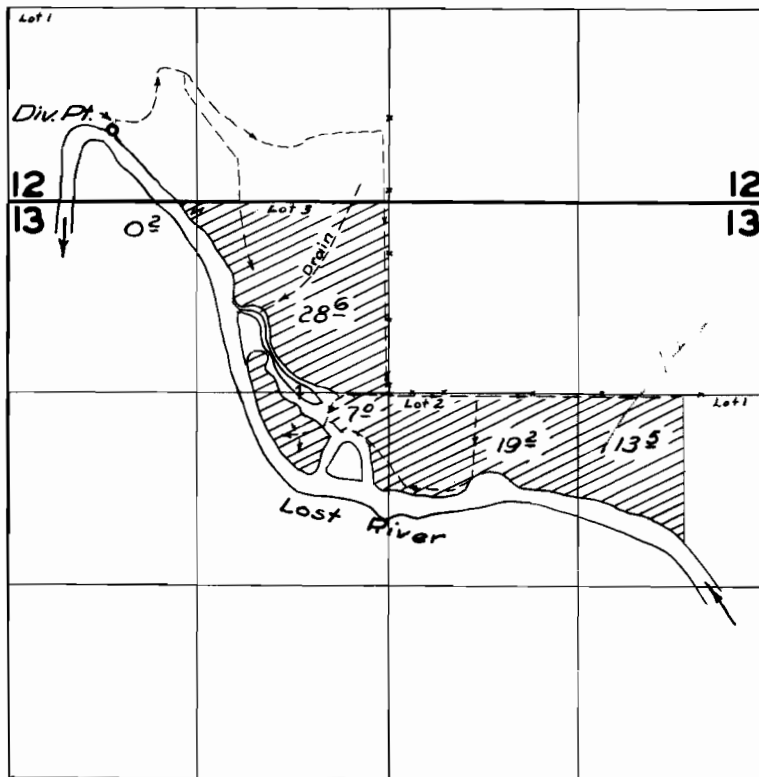

10°

FINAL PROOF SURVEY

UNDER

TRANSFER NO. S-96

Applied for by _____

IN FAVOR OF

GEO. E. STEVENSON

Witnessed Oct. 24 1859 by *M. Bish*