


T.5S. R.3E.W.M.

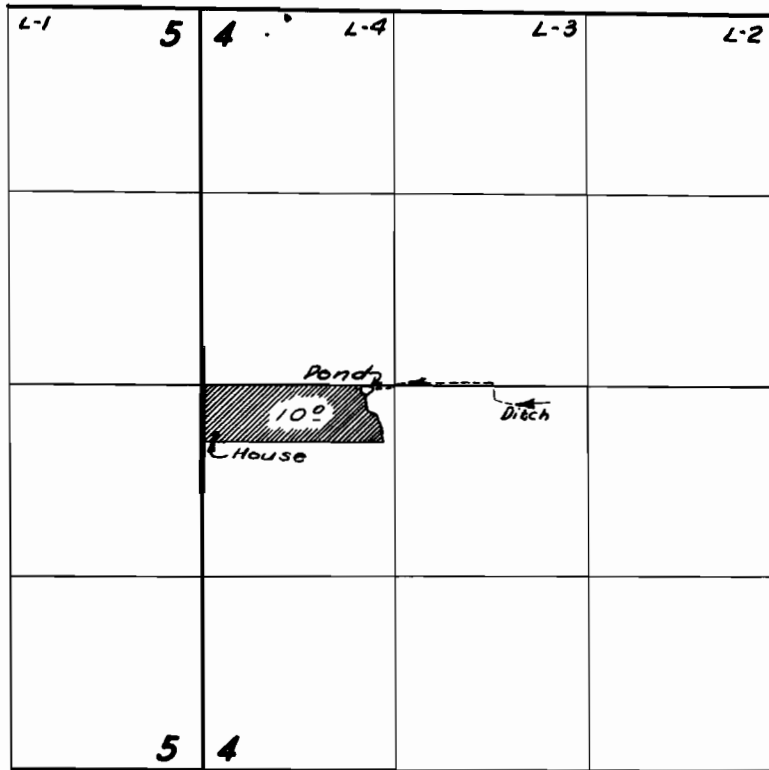

**FINAL PROOF SURVEY**  
UNDER

Application No. S-101 Permit No. \_\_\_\_\_  
IN NAME OF

CLEO K. STEWART

Surveyed 18 June 1958, by C.O. Bartels.