


T. 9 S. R. 45 E. W. M.

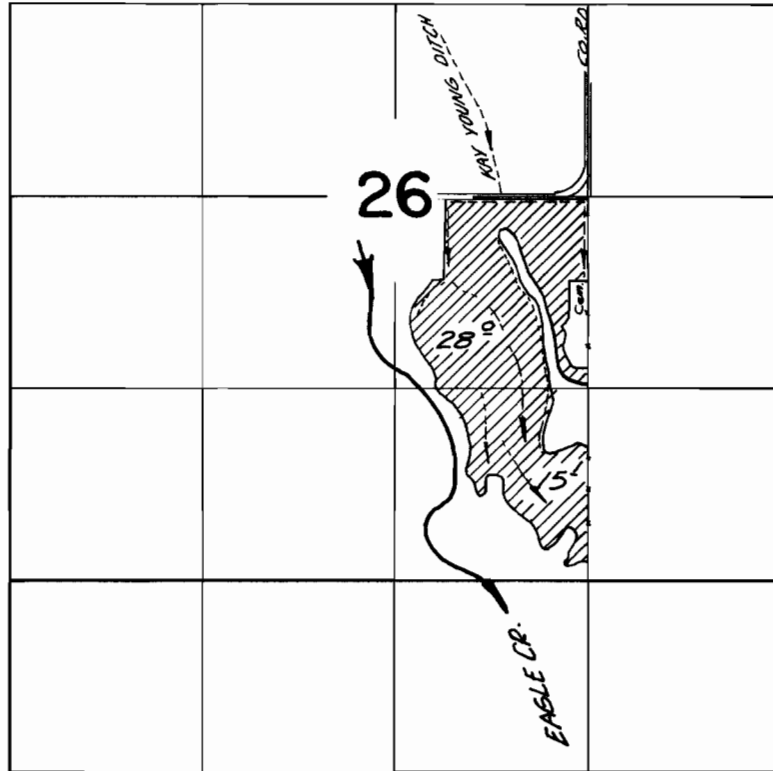

**FINAL PROOF SURVEY**  
UNDER

*TRANSFER S-113*  
Application No. .... Permit No. ....  
IN NAME OF

..... *CLAUS P. SASS* .....

Surveyed *Aug. 11, 1966*, by *V. GARNER* .....