


T.18S. R.11E. W.M.

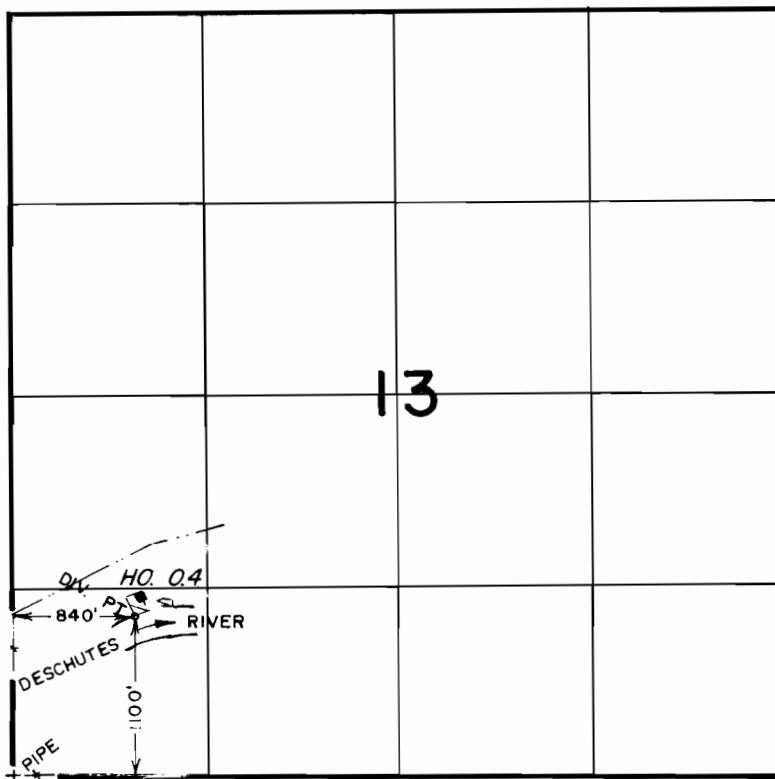

FINAL PROOF SURVEY
UNDER

TRANSFER S-119
Application No. Permit No.
IN NAME OF

HELEN M. THOMPSON

Surveyed JUN. 3. 1982., by L.H. NUNN