


T. 1 N. R. 14 E. W.M.

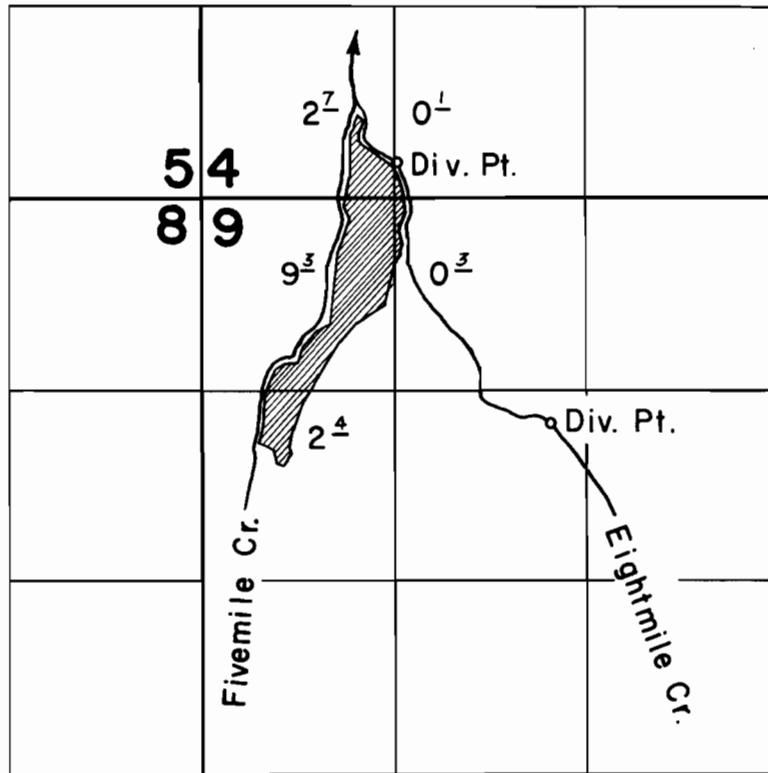

**FINAL PROOF SURVEY**  
UNDER

Transfer No. S-136 & S-150  
IN NAME OF

JOHN F. STANEK

Surveyed Dec. 12, 1962, by *S. W. Gebresch*