


T. 1 N. R. 14 E. W.M.

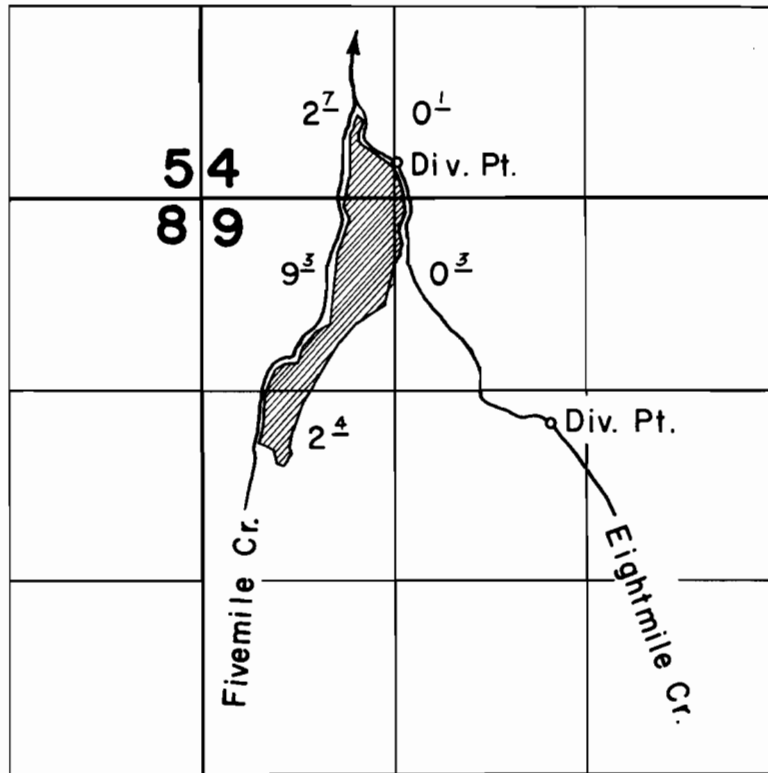

FINAL PROOF SURVEY
UNDER

Transfer No. S-136 & S-150
IN NAME OF

..... JOHN F. STANEK

Surveyed Dec. 12, 1962, by *S. W. Gebresch*