


TWP 39 S R 8 WWM

Sec. 25

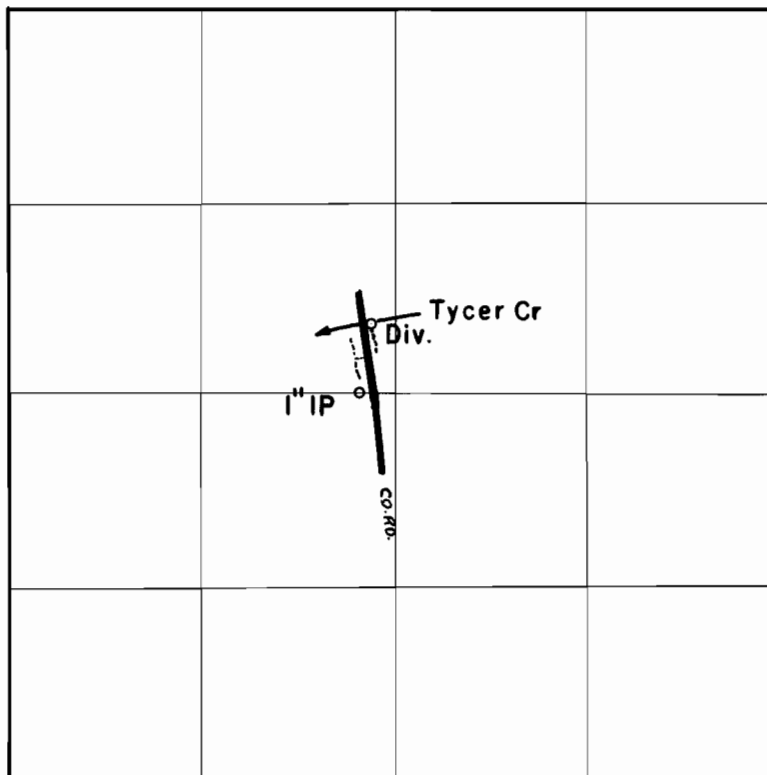

FINAL PROOF SURVEY
UNDER

Application No. _____ Trans
Permit No. S-141
IN NAME OF

..... Harry O. Smith.....

Surveyed ...6-7... 19.62, by R. Steimer.....