


T. 7 S. R. 4 W. W. M.

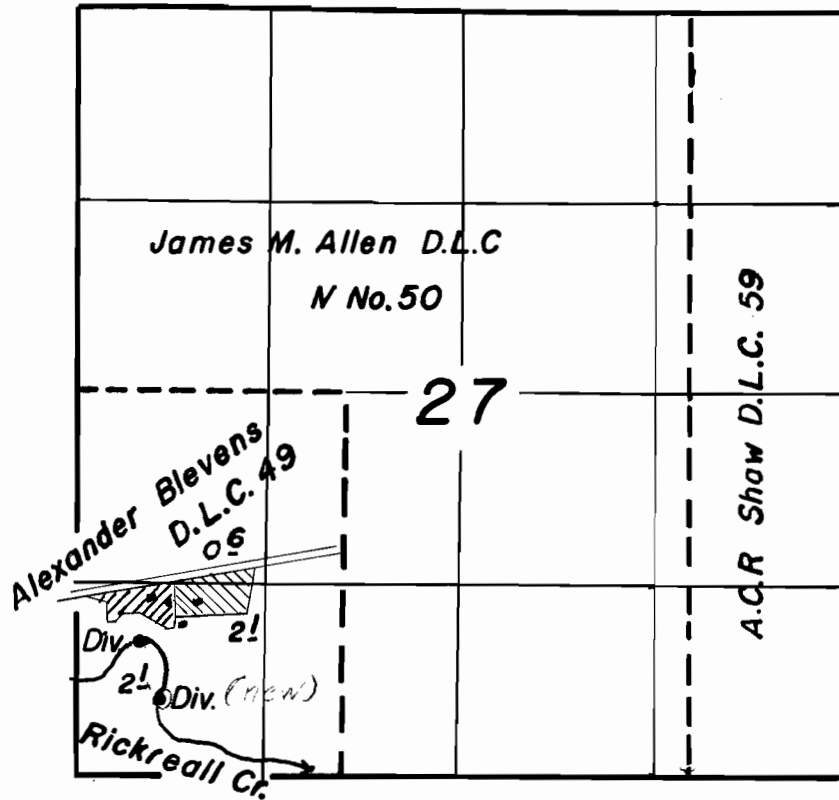

FINAL PROOF SURVEY
UNDER

TRANSFER NO. S-152

Application No. _____ Permit No. _____
IN NAME OF

Bruce W. Williams

Surveyed **NOV. 7** 1963, by *Floyd L. Sigmund*