


T. 34 S., R. 1 W., W.M.

Sec. 21

NE 1/4 SE 1/4

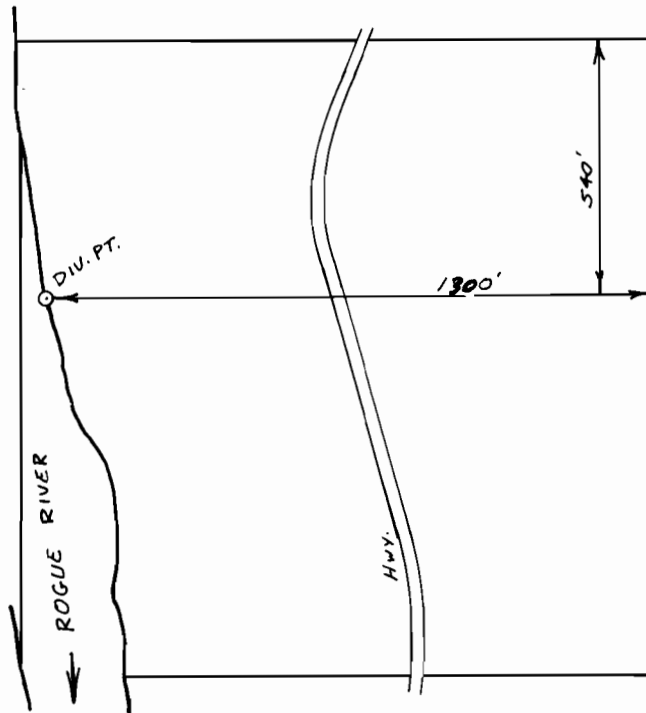

Scale 1" = 400'

FINAL PROOF SURVEY

UNDER

Transfer no. S-153

Application No. Permit No.

IN NAME OF

DALE & JOANN L. SATTLER.....

INSPECTION

Surveyed DEC. 17, 1979, by B. SUND.....