


T. 1S. R. 33E. W.M.

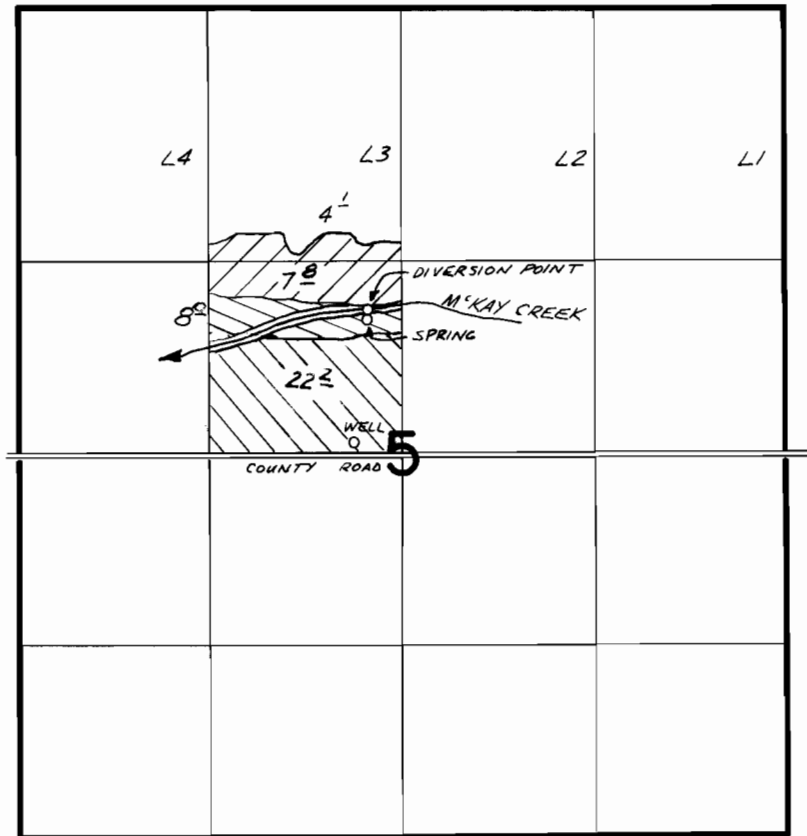

WELL LOCATED 0' N. & 320' W. FROM SE COR SE 1/4 NW 1/4 SEC 5
 SPRING LOCATED 910' N. & 230' W. FROM SE COR SE 1/4 NW 1/4 SEC 5
 DIVERSION POINT LOCATED 980' N. & 250' W. FROM SE COR SE 1/4 NW 1/4 SEC 5

FINAL PROOF SURVEY UNDER

TRANSFER S-156
 44465 33258

Application No. G-6742 Permit No. G-6267
 IN NAME OF

RICHARD V. & JANIECE H. STANHOPE

Surveyed OCT. 5 1977, by R. BARWIN
MAR 30 '78

PRIMARY



SUPPLEMENTAL

